


T.38&4S.R.4 E. W.M.

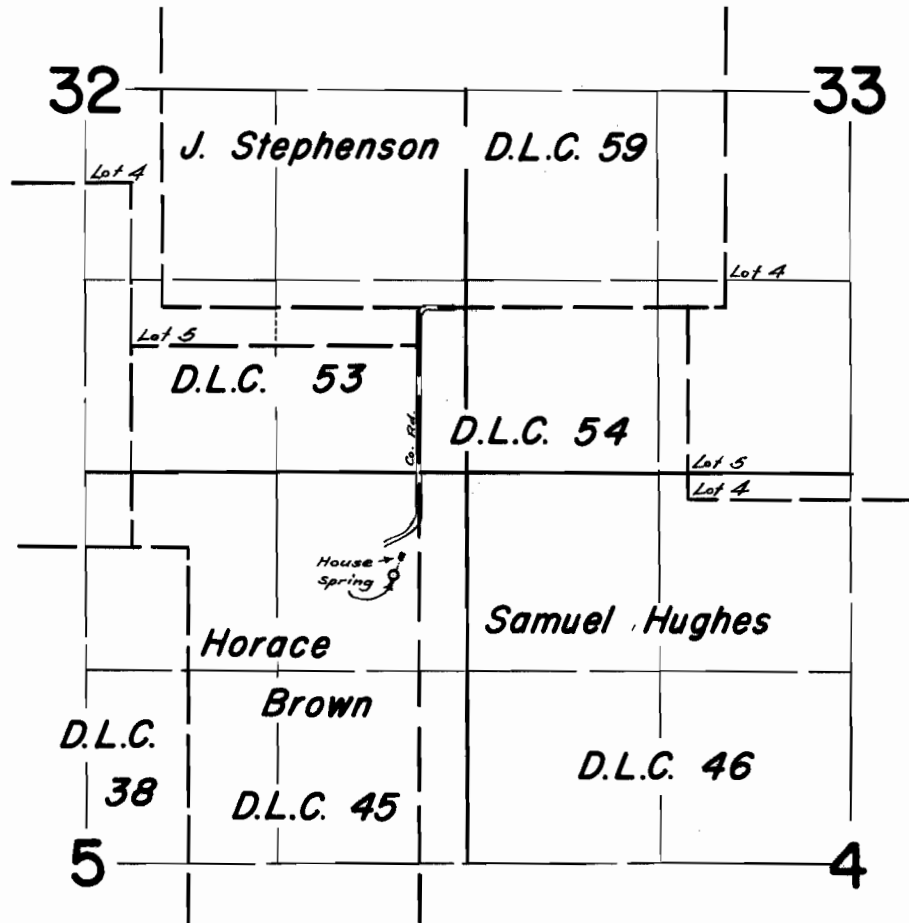

FINAL PROOF SURVEY
UNDER

Application No. 31434 Permit No. 24795
IN NAME OF

WILLIAM A. FLOYD

Surveyed May 27 1963, by

[Signature]