


T.3S.R.4&5E.W.M.

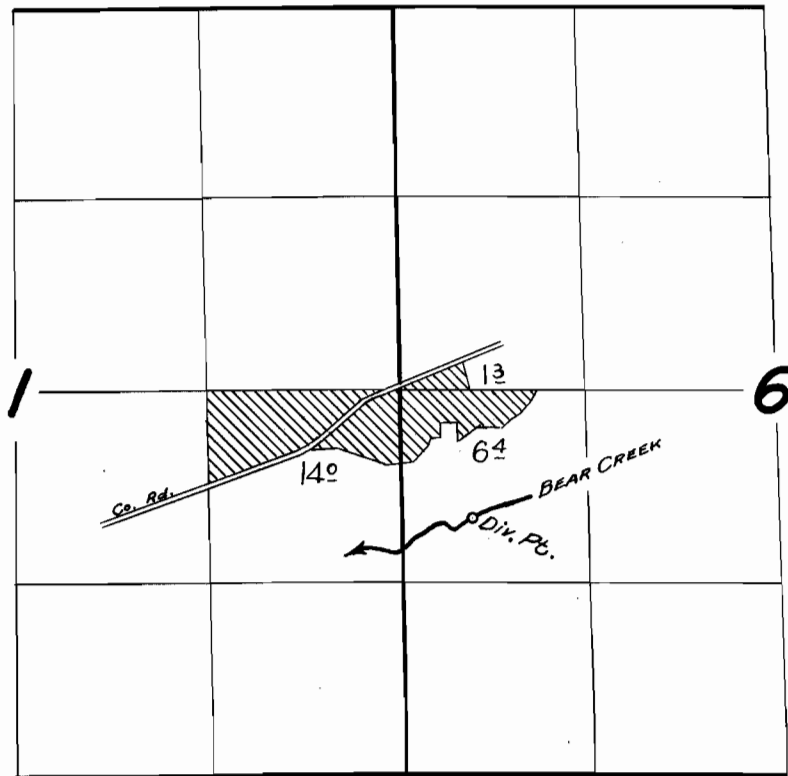

FINAL PROOF SURVEY
UNDER

Application No. 33002... Permit No. 26096...
IN NAME OF

WILLARD A. CRIPPS

Surveyed July 26, 1963, by T. Lower