


T.6S.R.1E.W.M.

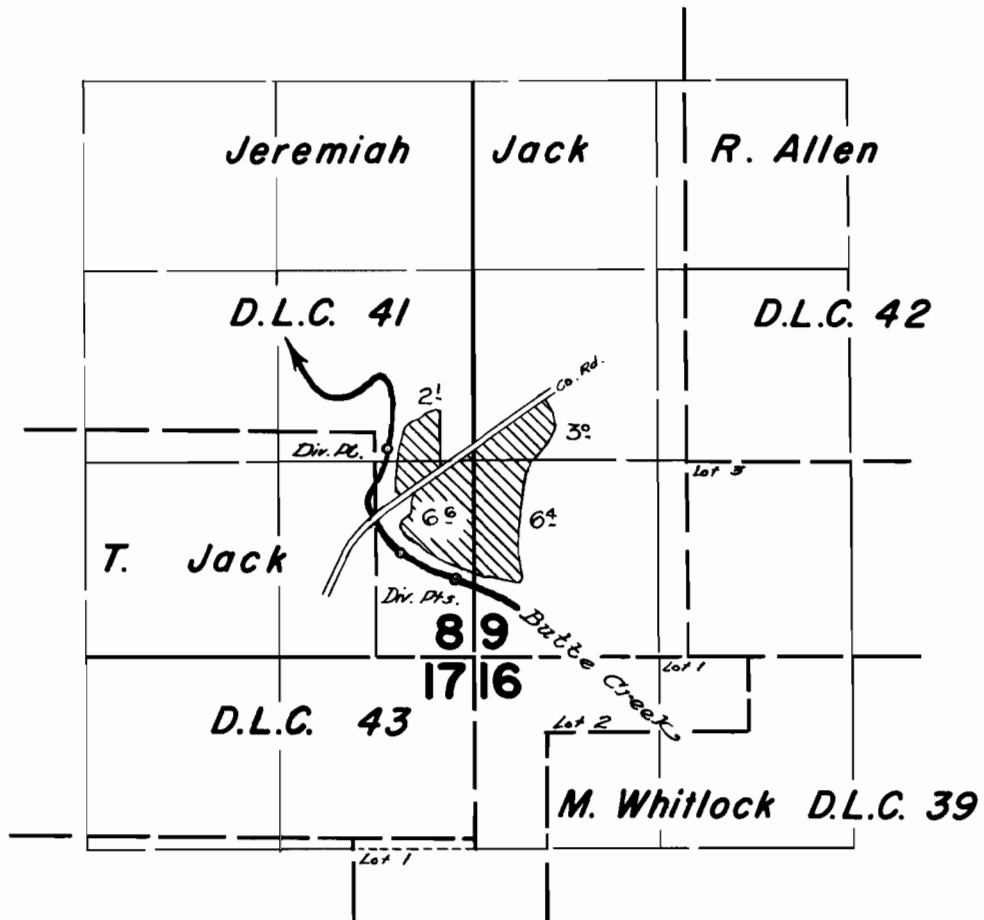

FINAL PROOF SURVEY UNDER

Application No. 33070... Permit No. 26152.....
IN NAME OF

CARL E. BLACKLER

Surveyed April 16 1963, by

H. Jackson