


T.2S.R.2&3E.W.M.

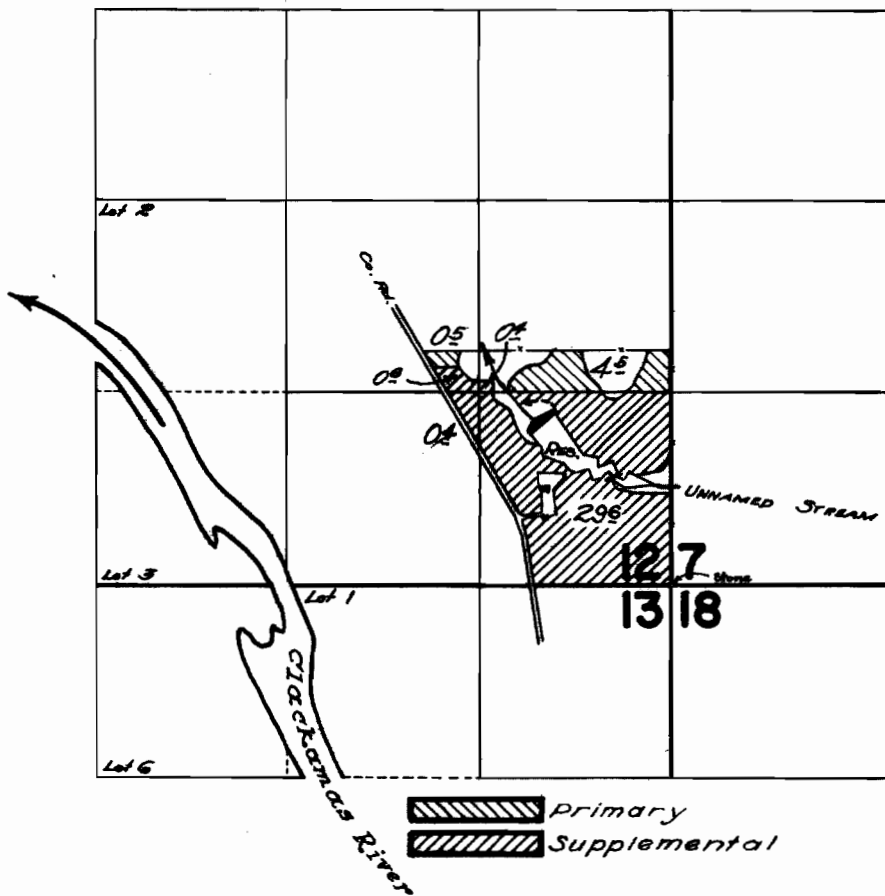

FINAL PROOF SURVEY UNDER

R-33183 R-2256
Application No. 33184 Permit No. 26246
IN NAME OF

G. F. HABERLACH

Surveyed May 1, 1963, by *Johnson*