


T. 3 S. R. 8 1/2 E. W. M.

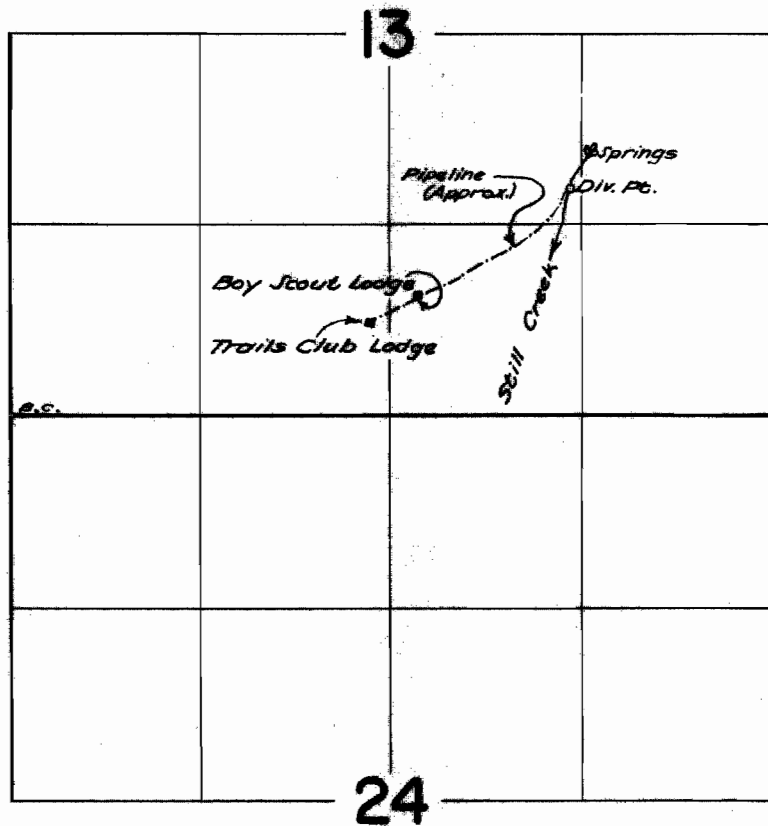

FINAL PROOF SURVEY
UNDER

Application No. 35091... Permit No. 27542...
IN NAME OF
U. S. FOREST SERVICE
MT. HOOD NATIONAL FOREST

Surveyed July 30, 1962, by T. Lauer.....