


T. 3 S. R. 1 E. W. M.

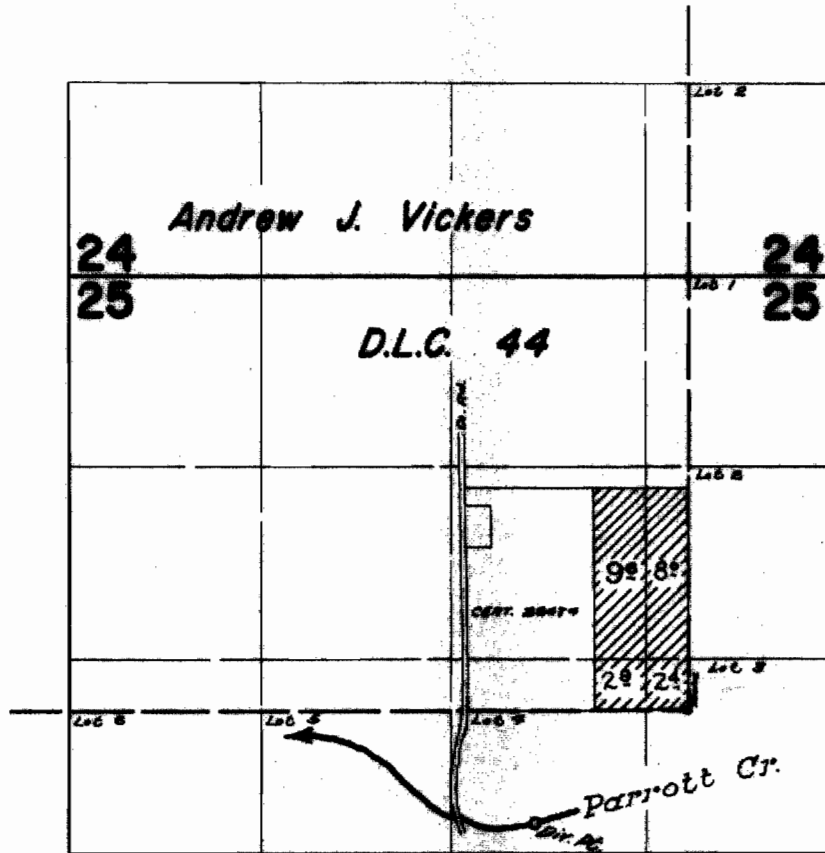

FINAL PROOF SURVEY UNDER

Application No. 37069... Permit No. 27578...
IN NAME OF

GORDON L. SCHOONOVER

Surveyed April 17, 1963, by *[Signature]*