


T.5S.R.2E.W.M.

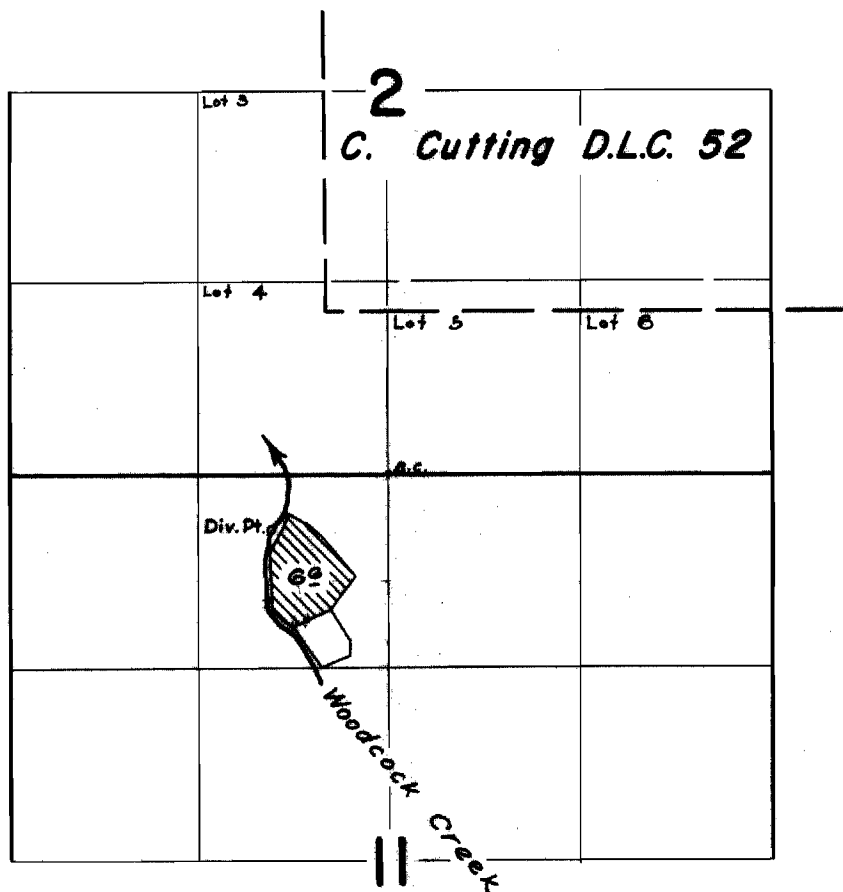

FINAL PROOF SURVEY
UNDER

Application No. 37084... Permit No. 27607...
IN NAME OF

ESTATE OF EARL D. PEEPLES

Surveyed May 29, 1963, by *L. Jackson*