


# T.2S.R.1E.W.M.

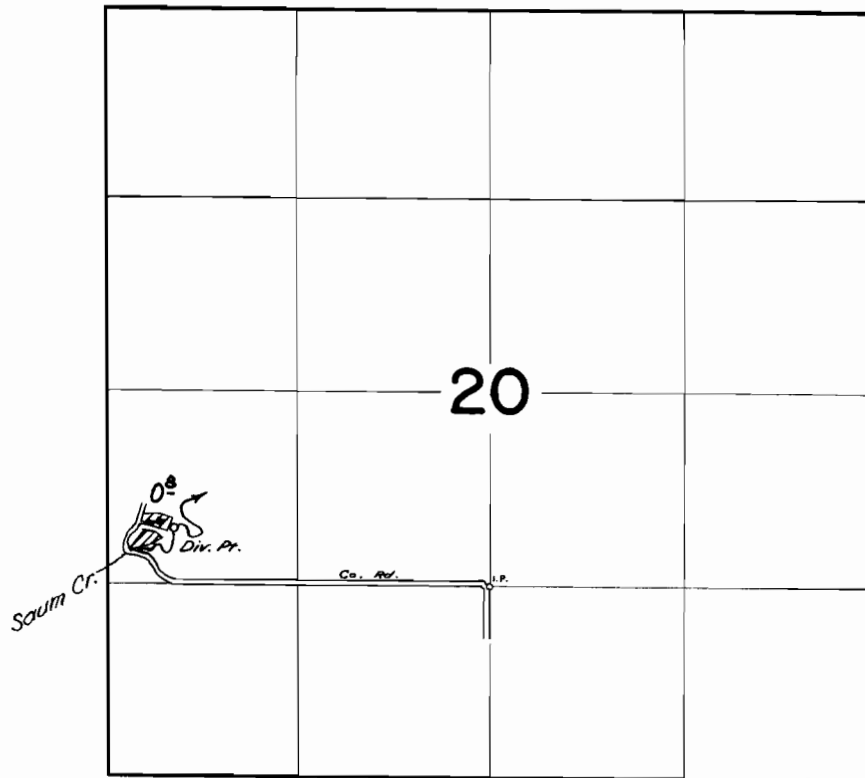

## FINAL PROOF SURVEY UNDER

Application No. **37678** ... Permit No. **28081** ...  
IN NAME OF

**ERVIN & VADAH DUNN**

Surveyed May 3 1963 by *R. Jackson*