


T.4S.R.IE.W.M.

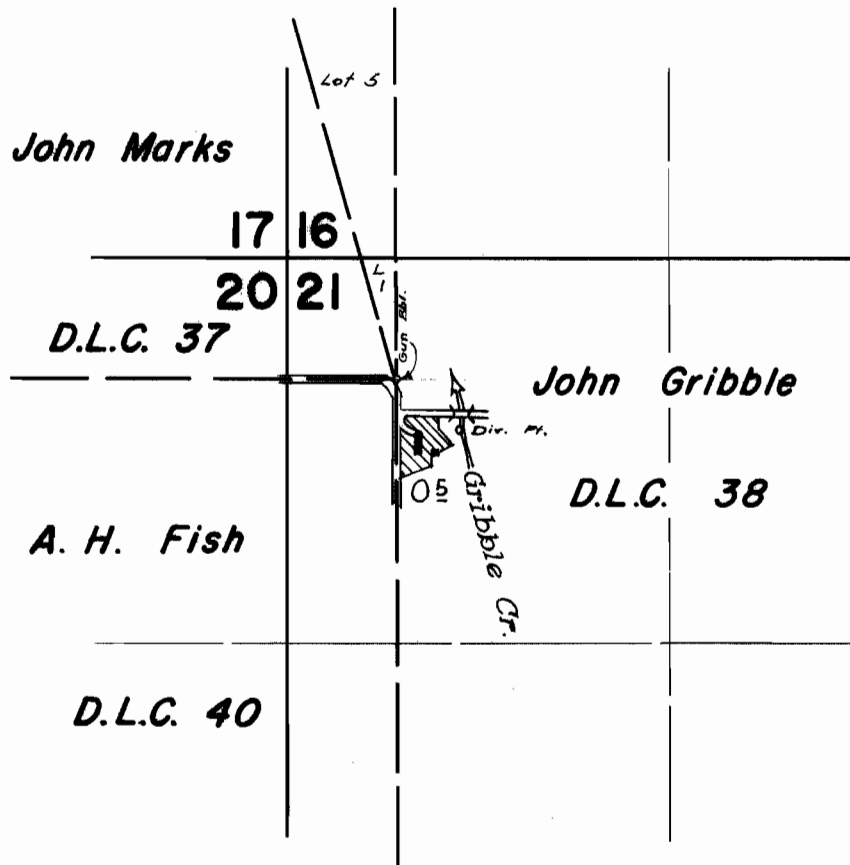

SCALE: 1" = 660'

FINAL PROOF SURVEY UNDER

Application No. 38060... Permit No. 28382...
IN NAME OF

ARTHUR D. & LOIS A. IRISH

Surveyed May 29, 1963, by