


T.28S.R.10W.W.M.

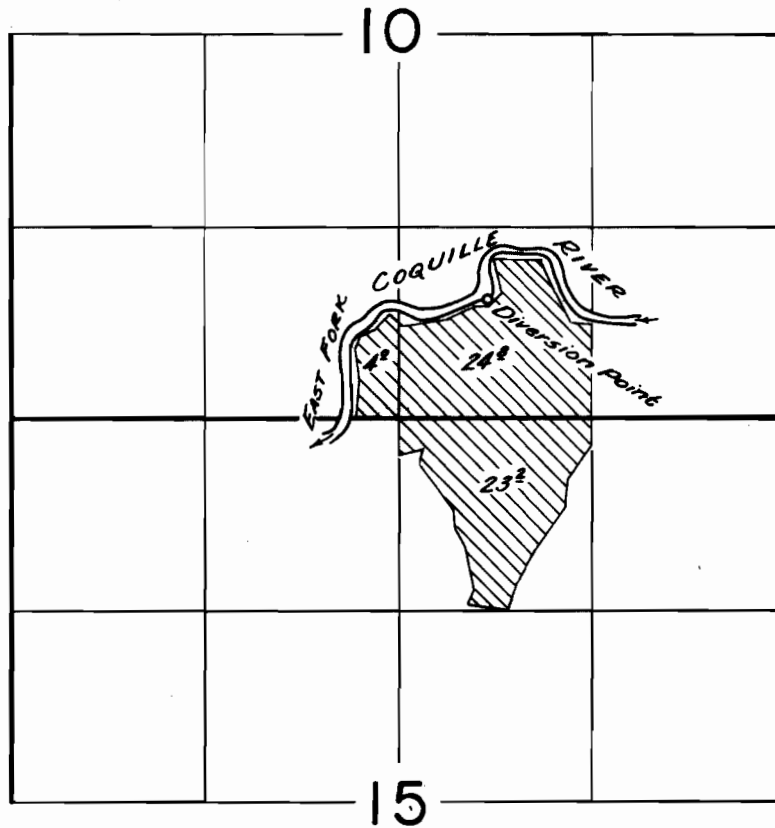

**FINAL PROOF SURVEY**  
UNDER

Application No. 33289 Permit No. 26308  
IN NAME OF

John Edwin Crowley

Surveyed Aug. 6 1963, by C. Baker