


T.29S.R.12W.W.M.

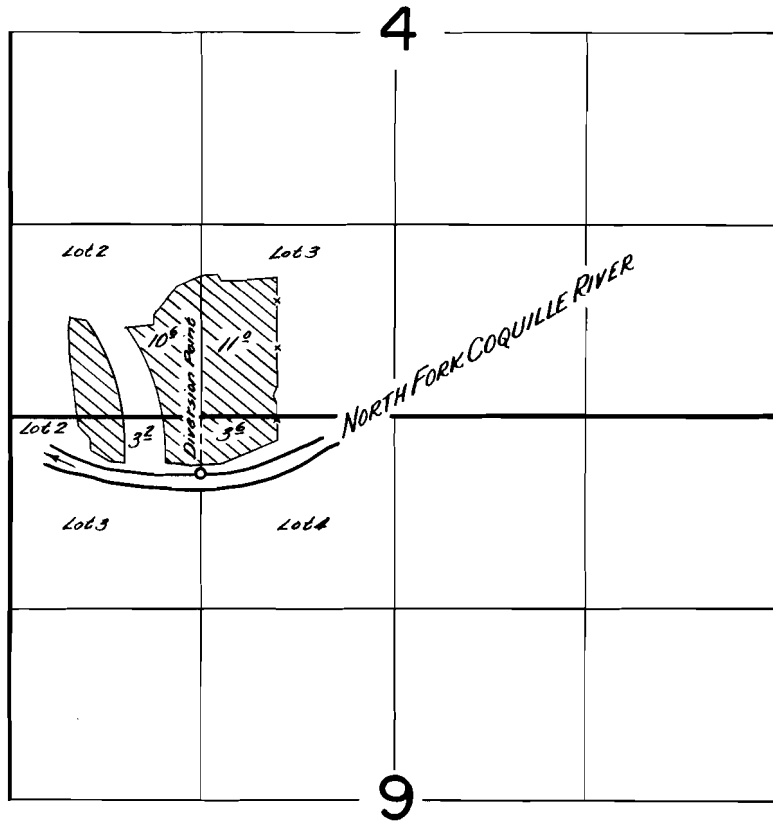

**FINAL PROOF SURVEY**  
UNDER

Application No. 33555 Permit No. 26533  
IN NAME OF

James Leibelt

Surveyed Aug. 8 1963, by C. Baker