


T. 28S. R. 10W. W.M.

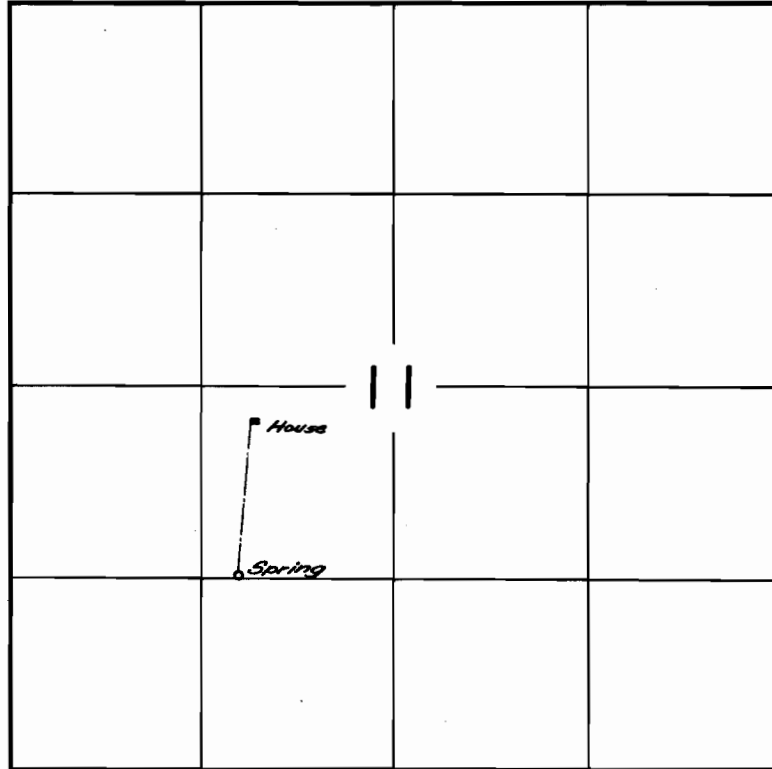

**FINAL PROOF SURVEY**  
UNDER

Application No. 34568. Permit No. 27149...  
IN NAME OF

.....**Charles W. Wilson**.....

Surveyed Aug. 6..... 1963., by C. Baker.....