


T.14&15S.R.17E.W.M.

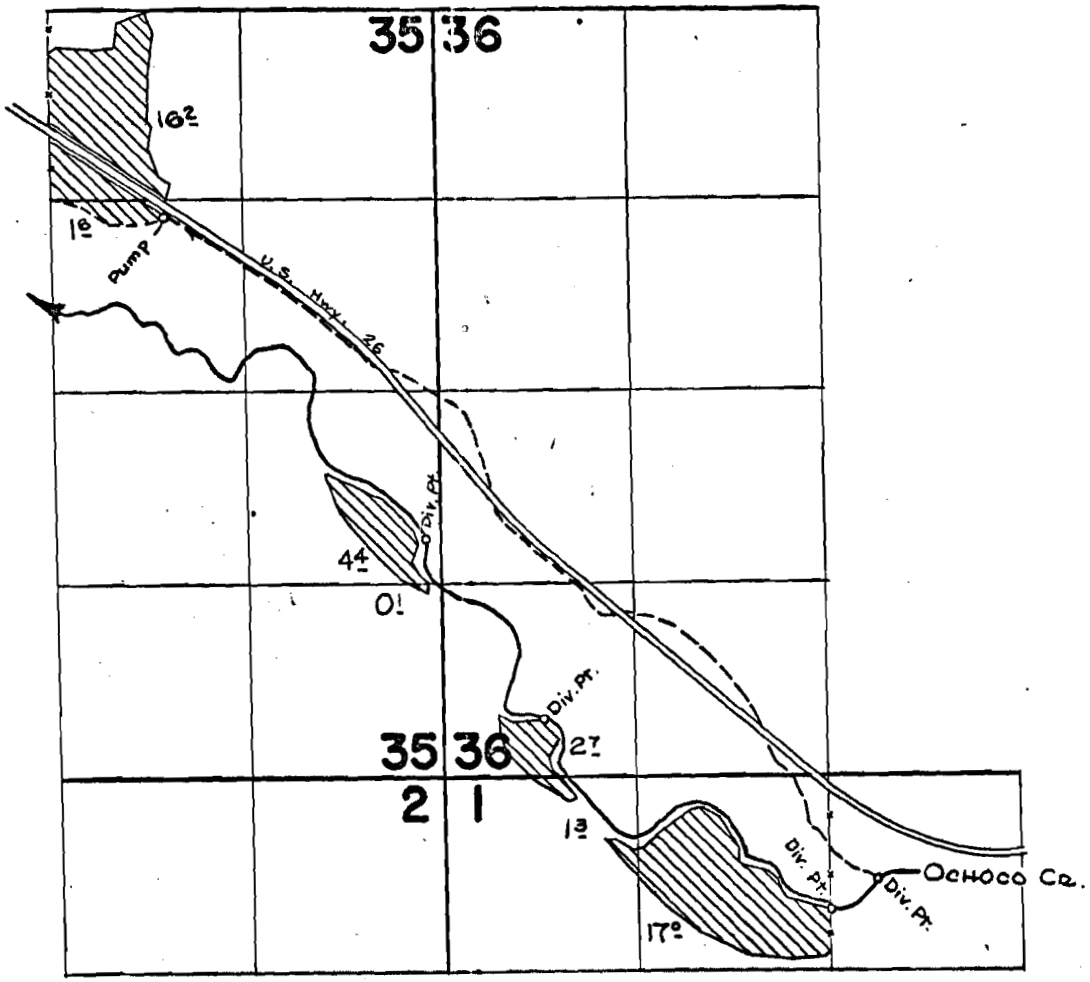

FINAL PROOF SURVEY UNDER


Application No. 32445... Permit No. 25622...
IN NAME OF

A. G. SCHNOOR

Surveyed July 12 1963, by T. LAUER

P# 25622
1963-8

T.14&15 S.R.17 E.W.M.

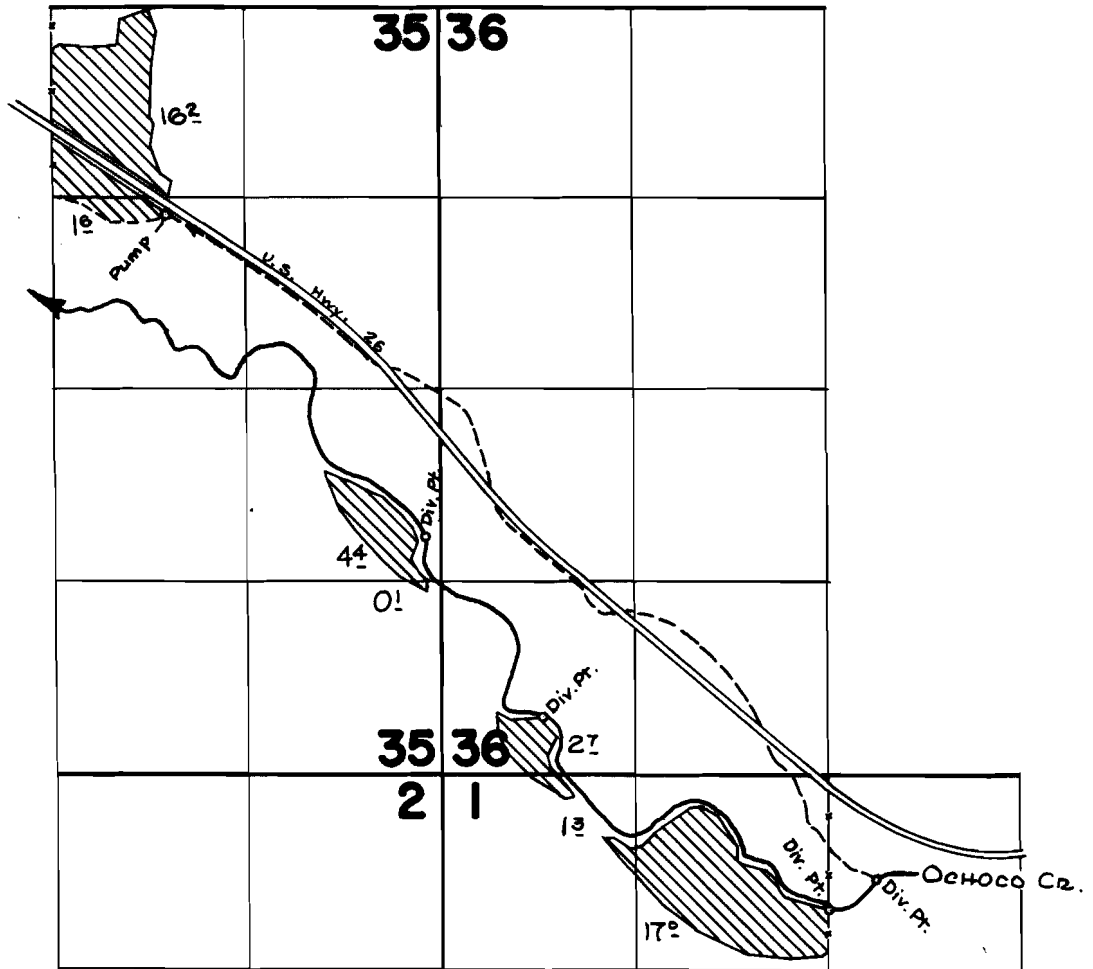

FINAL PROOF SURVEY UNDER

Application No. 32445... Permit No. 25622...
IN NAME OF

A. G. SCHNOOR

Surveyed July 12 1963, by T. LAUER

