


T.15S.R.16E.W.M.

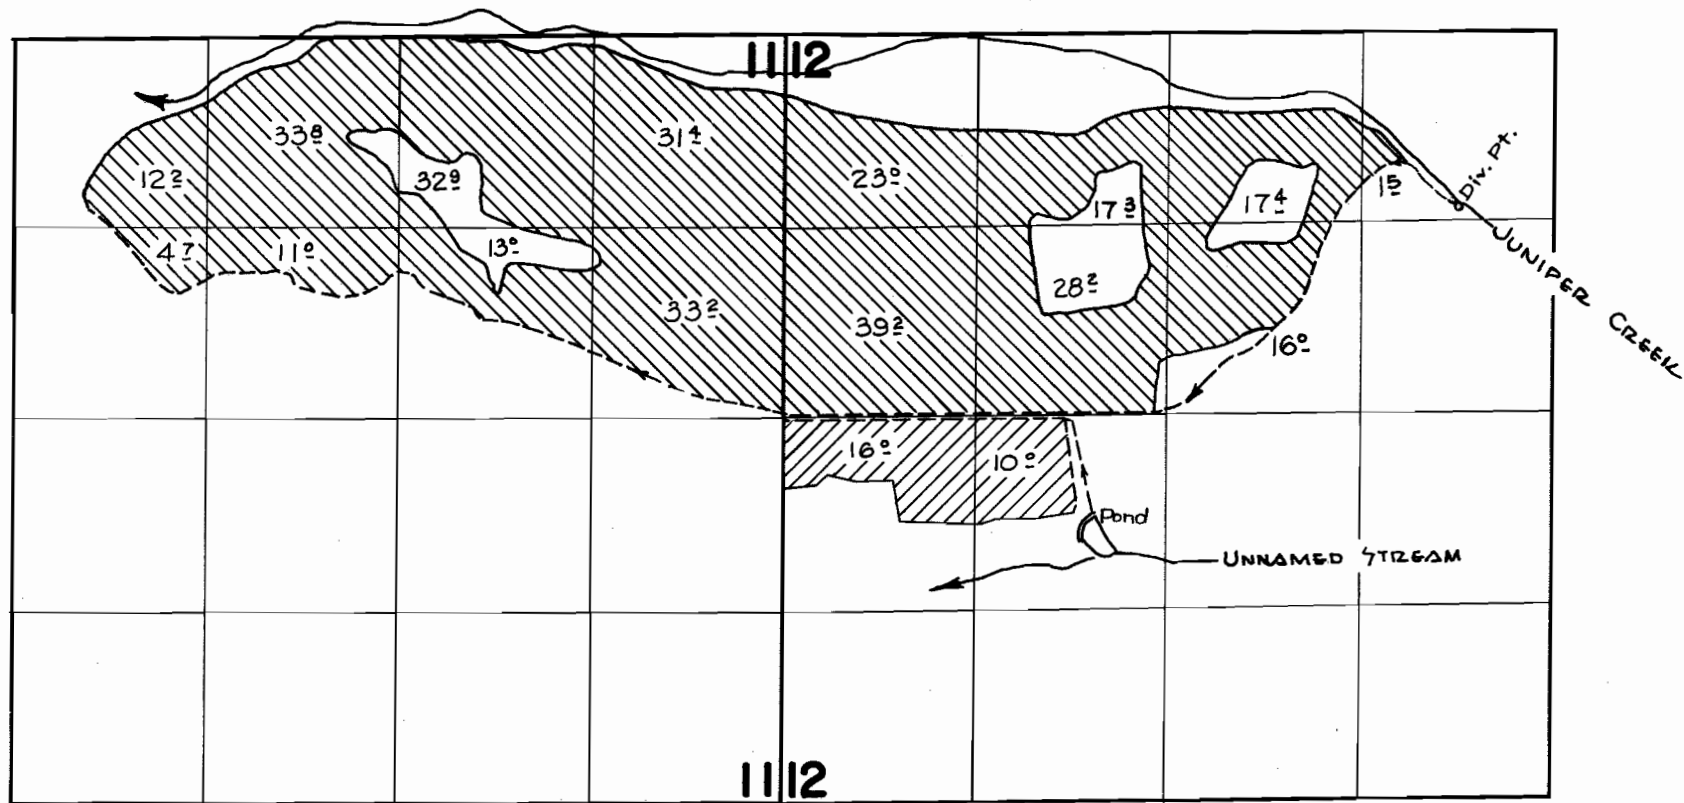

FINAL PROOF SURVEY

UNDER

APPLICATION NO. 32864 PERMIT NO. 26005

IN NAME OF

A. G. SCHNOOR

Surveyed July 17, 1963 by T. Lauer

21