


T.41S.R.13W.W.M.

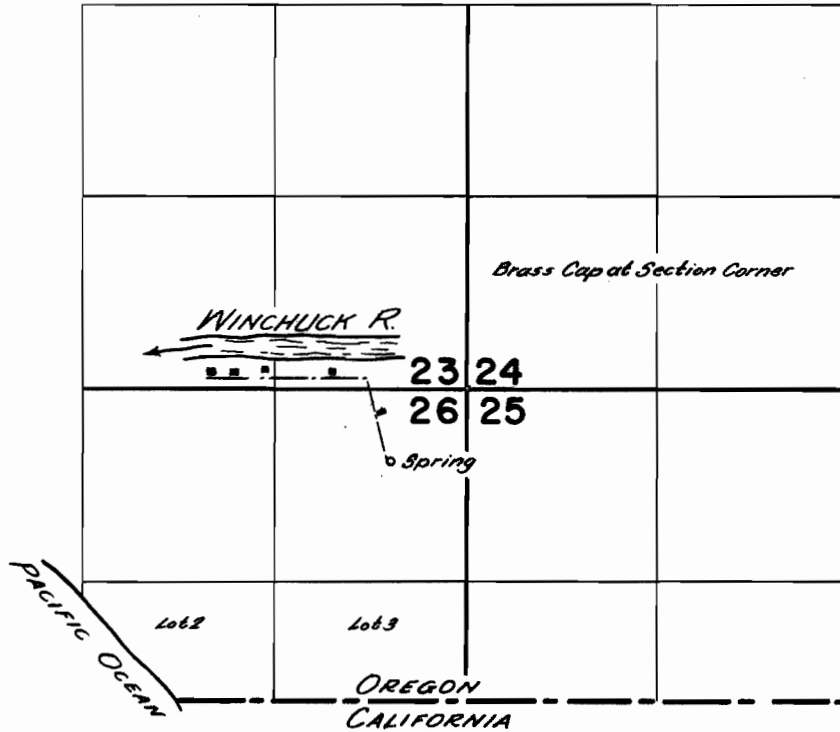

**FINAL PROOF SURVEY**  
UNDER

Application No. 38045 Permit No. 28380  
IN NAME OF

Priscilla M. Robinson

Surveyed Aug. 7 1963, by T. Lauer