


T.24S.R.7W.W.M

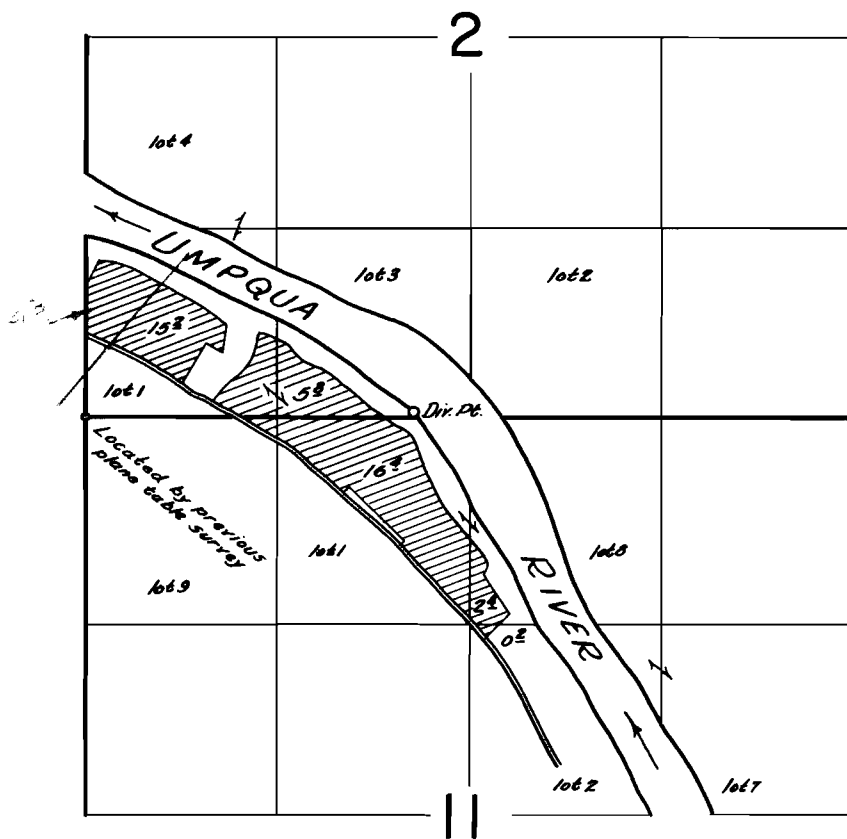

**FINAL PROOF SURVEY**  
UNDER

Application No. 32563 Permit No. 25778  
IN NAME OF

Milo Bullock

Surveyed April 10 1963, by C.O. Bartals