
T. 30S.R.6W.W.M.

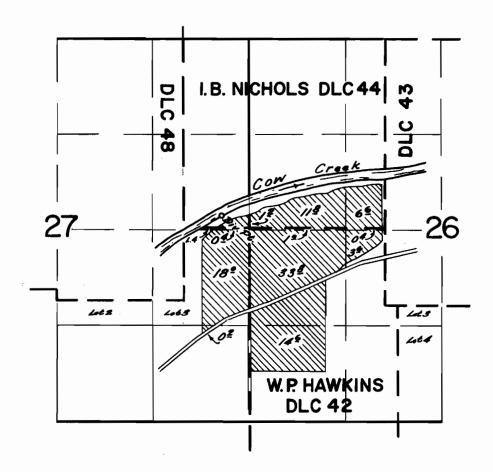

FINAL PROOF SURVEY

Application No. 32249 Permit No. 25824 IN NAME OF
J.L. Aikins
Surveyed April 4 1963, by .C.O. Bartels