


T.31S.R.2W.W.M.

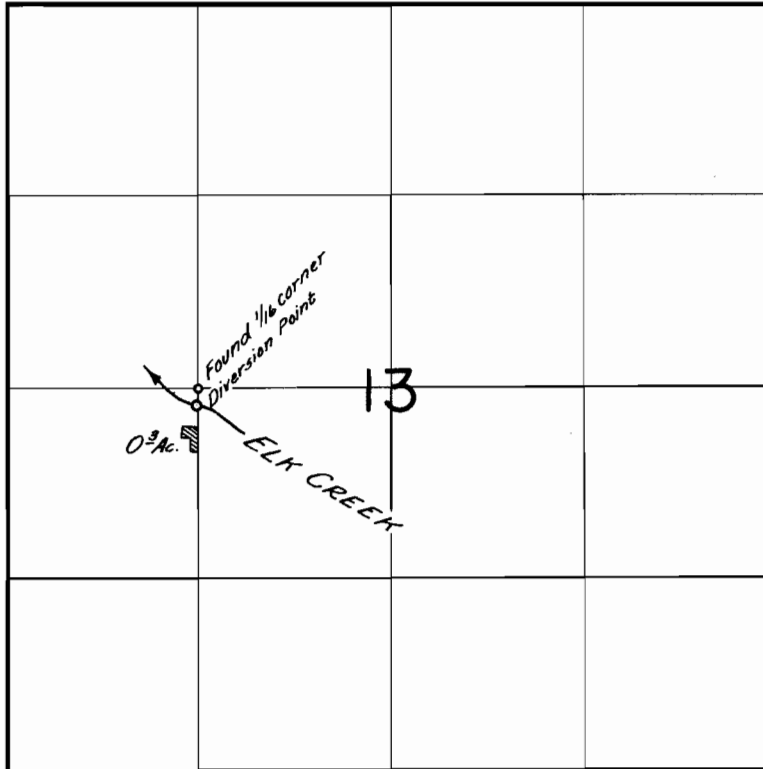

FINAL PROOF SURVEY
UNDER

Application No. 32981 Permit No. 26082
IN NAME OF

Avery & Sydna Greenman

Surveyed May 22 1963, by T. Lauer