


T.27S.R.3W.W.M.

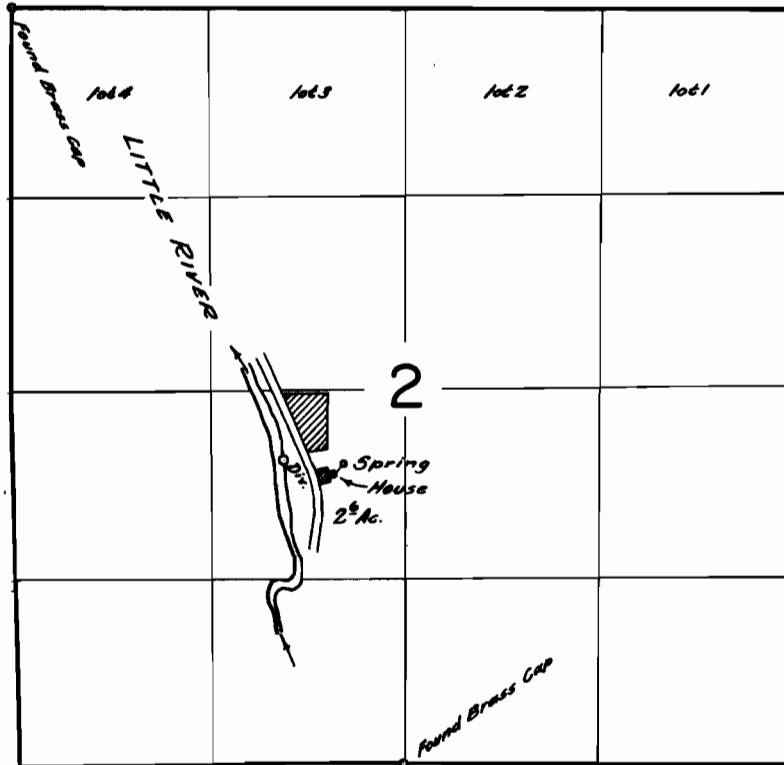

FINAL PROOF SURVEY
UNDER

Application No. 33220 Permit No. 26262
IN NAME OF

J. B. Forsythe

Surveyed April 1 1963, by G. O. Bartels