


T.29S.R.5W.W.M.

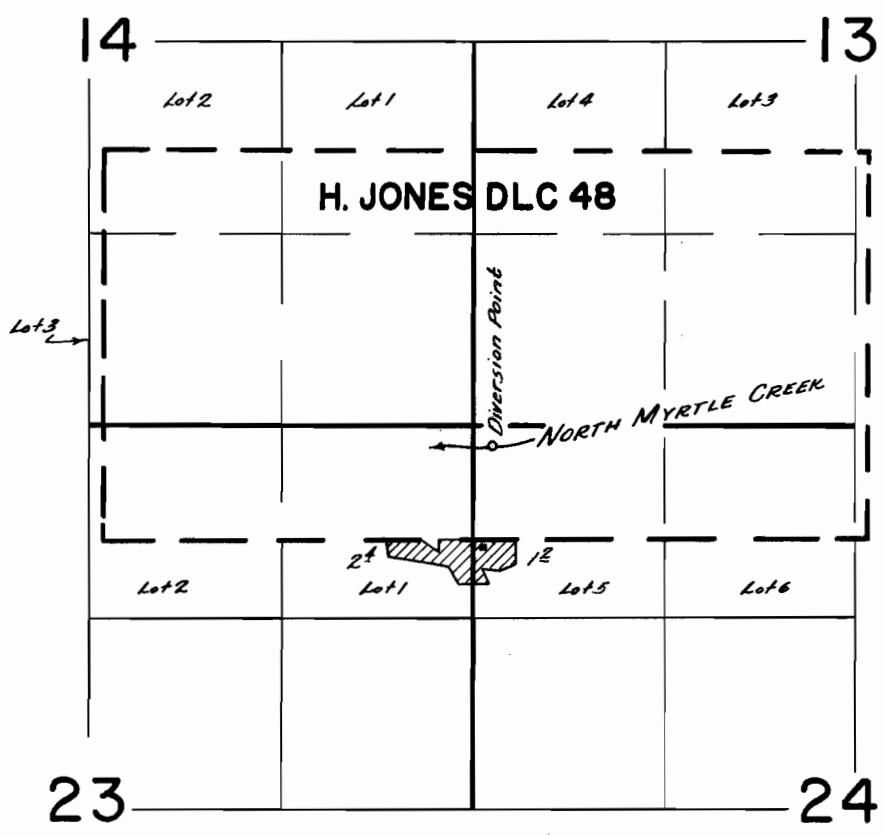

**FINAL PROOF SURVEY**  
UNDER

Application No. 37412 Permit No. 27864  
IN NAME OF

**Verlin M. & Darlene L. Mills**

Surveyed May 16 1963, by T. Lauer