


T.21S.R.4W.W.M.

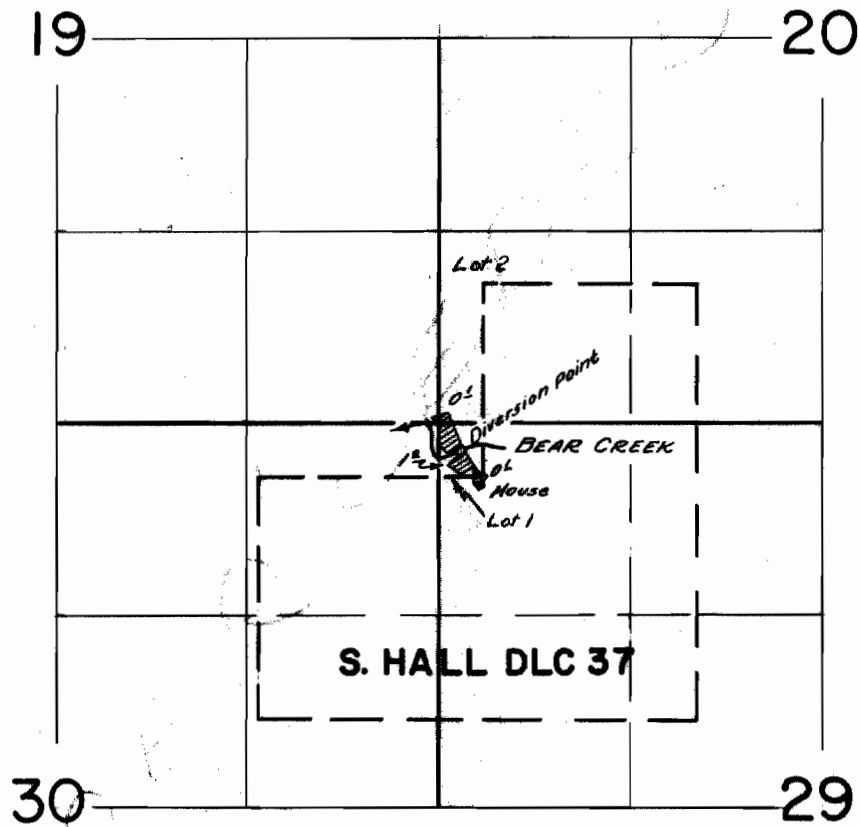

FINAL PROOF SURVEY
UNDER

Application No. 37552 Permit No. 28033
IN NAME OF

Irene D. Ames

Surveyed June 5 1963, by T. Lauer