


T.27S.R.6W.W.M.

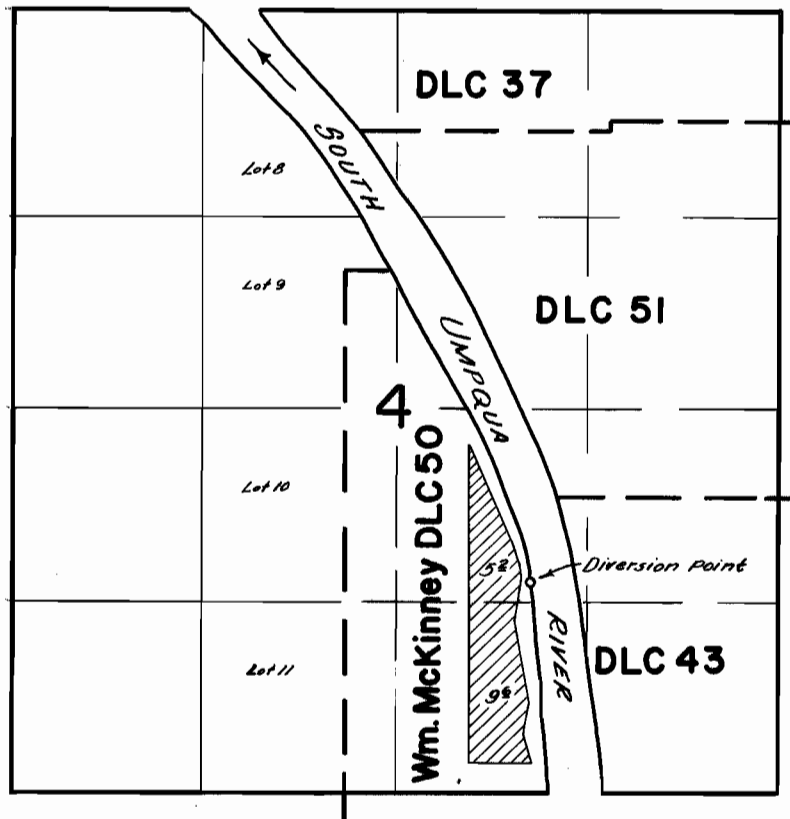

FINAL PROOF SURVEY
UNDER

Application No. 37763 Permit No. 28190
IN NAME OF

Mr. Carroll Sensabaugh

Surveyed May 17, 1963, by J. Lauer