


T.26S.R.3W.W.M.

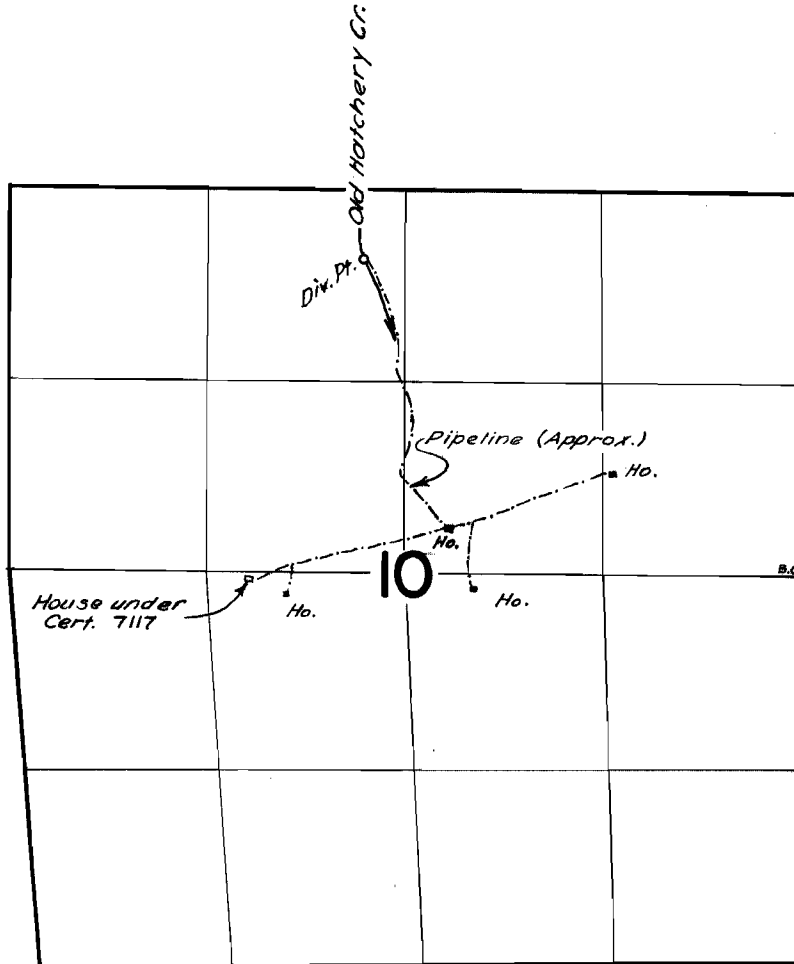

**FINAL PROOF SURVEY**  
UNDER

Application No. 37878... Permit No. 28286...  
IN NAME OF  
Albert De Bernardi- Dick De Bernardi  
Den De Bernardi- Lincoln Kennady

Surveyed June 8, 1963, by T. Lauer