


T.26S.R.6W.W.M.

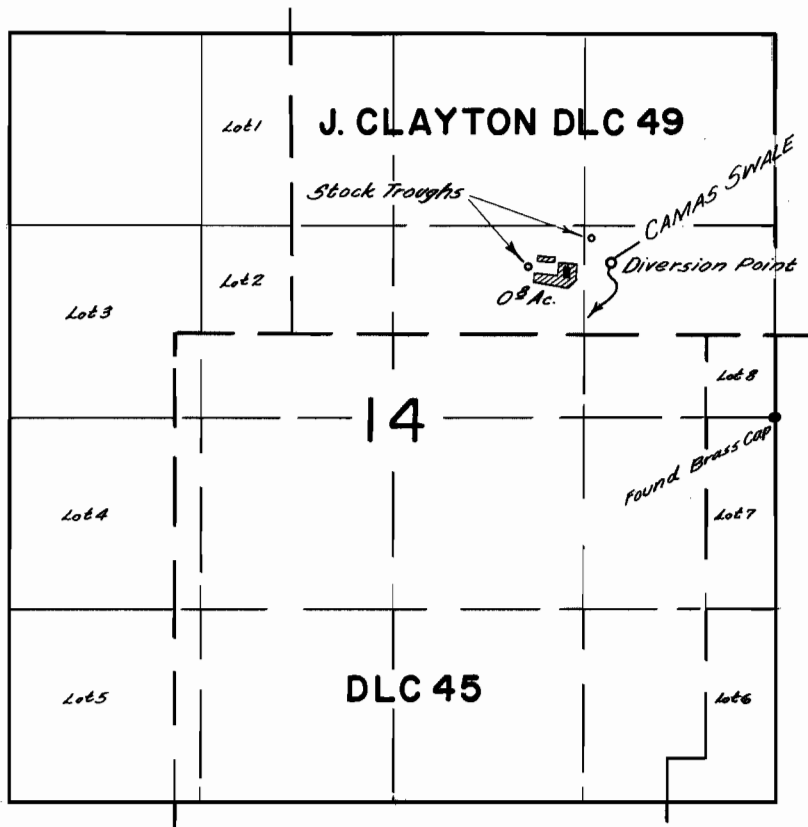

FINAL PROOF SURVEY
UNDER

Application No. 37898 Permit No. 28366
IN NAME OF

Harold D. McKay

Surveyed June 6 1963, by T. Lauer