


T.28S.R.7W.W.M.

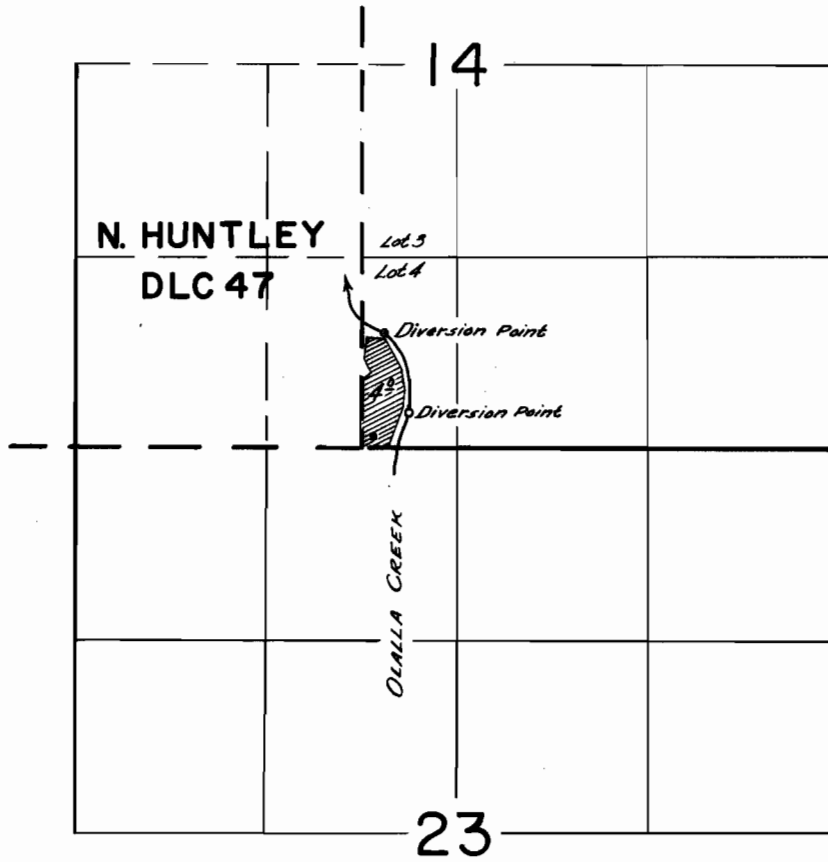

FINAL PROOF SURVEY
UNDER

Application No. 38095. Permit No. 28398...
IN NAME OF

.....Carl A. Larsen.....

Surveyed May.14... 1963, by T.Lauer.....