


T.27S. R.6W.W.M.

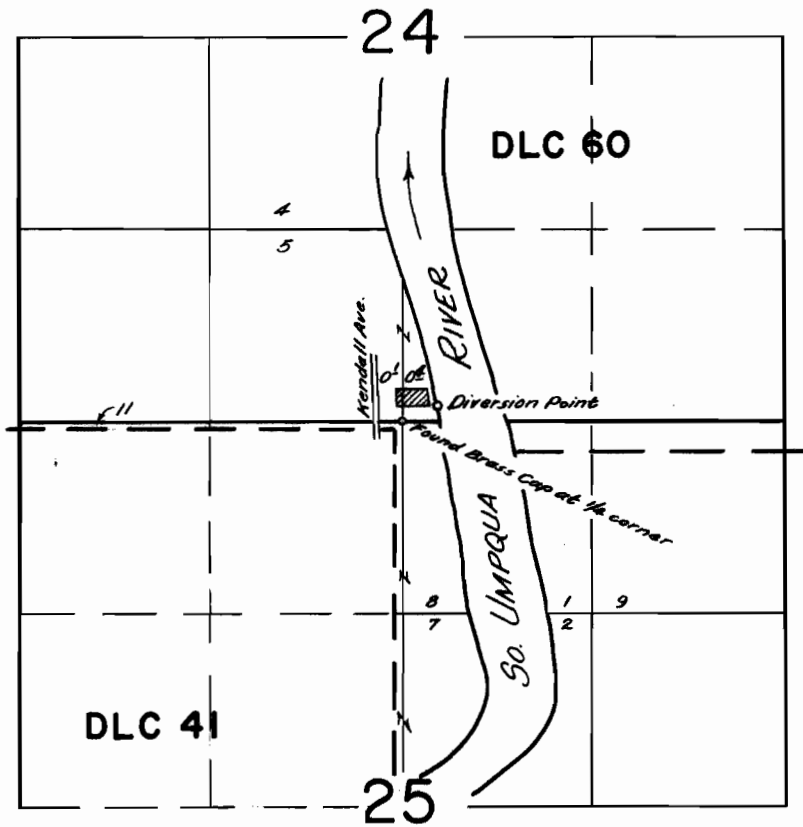

**FINAL PROOF SURVEY**  
UNDER

Application No. 38130... Permit No. 28416...  
IN NAME OF

.....**Robert A. & Gloria S. Driver**.....

Surveyed May 15, 1963, by T. Lauer.....