


T.39S.R.35E.W.M.

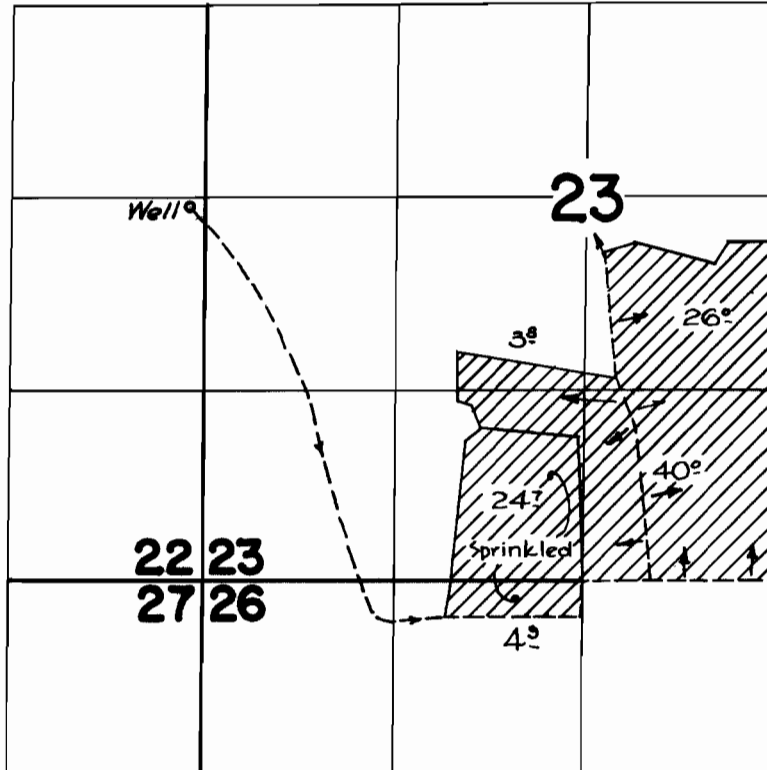

**FINAL PROOF SURVEY**  
UNDER

Application No. G-109 Permit No. G-23...  
IN NAME OF

WARREN MCLEAN

Surveyed Aug. 27 1963 by C. D. BAKER

*Handwritten signature*