


T.23S.R.30&31 E.W.M.

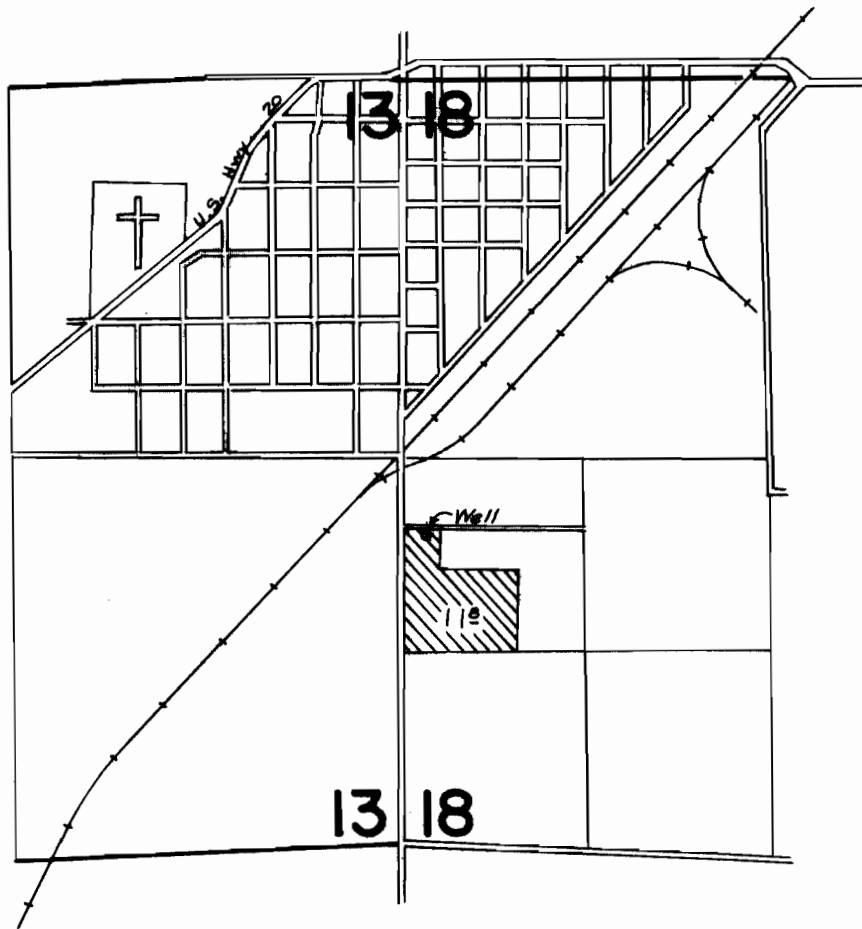

**FINAL PROOF SURVEY**  
UNDER

Application No. G-937 Permit No. G-888  
IN NAME OF

LEONARD H. HUGHET

Surveyed SEPT. 14 1963, by C. R. BAKER

*RK*