


T.26S.R.31E.W.M.
South of Malheur Lake

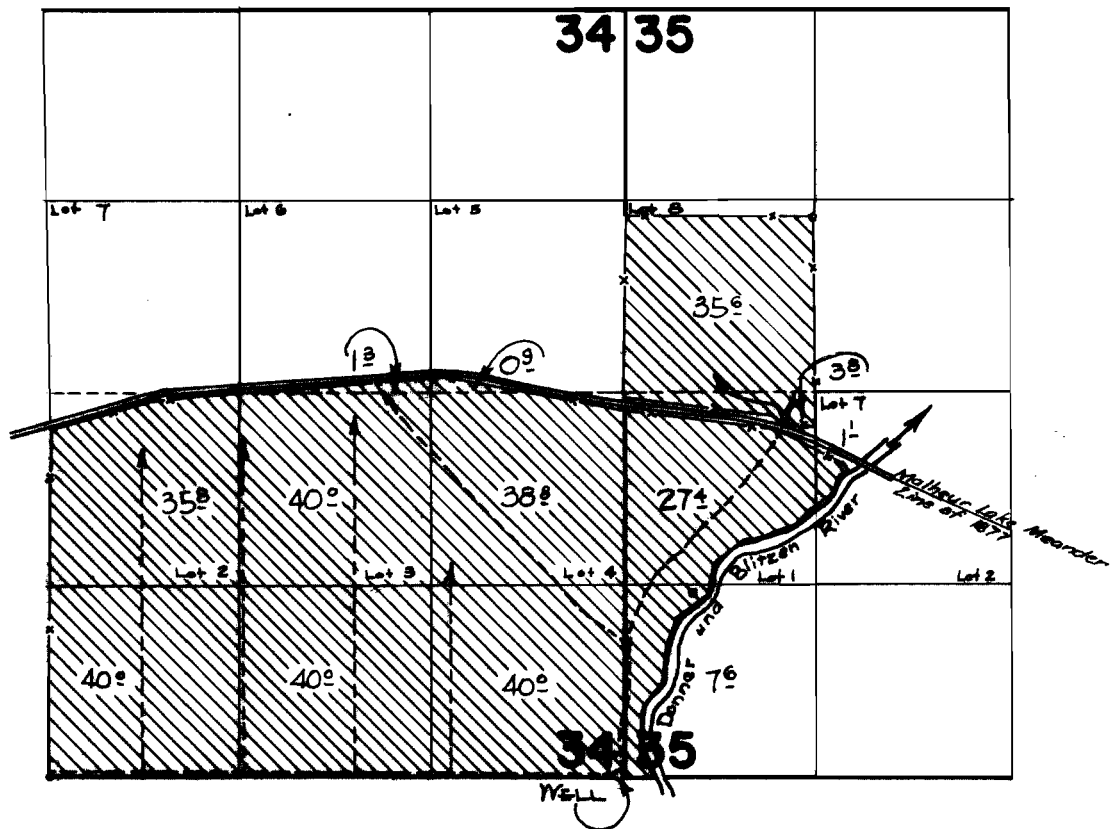

FINAL PROOF SURVEY
UNDER

Application No. G-1536 Permit No. G-1422
IN NAME OF

MARCUS J. HAINES

Surveyed SEPT. 18, 1963 by C. R. BAKER