


T.23S.R.34E.W.M.

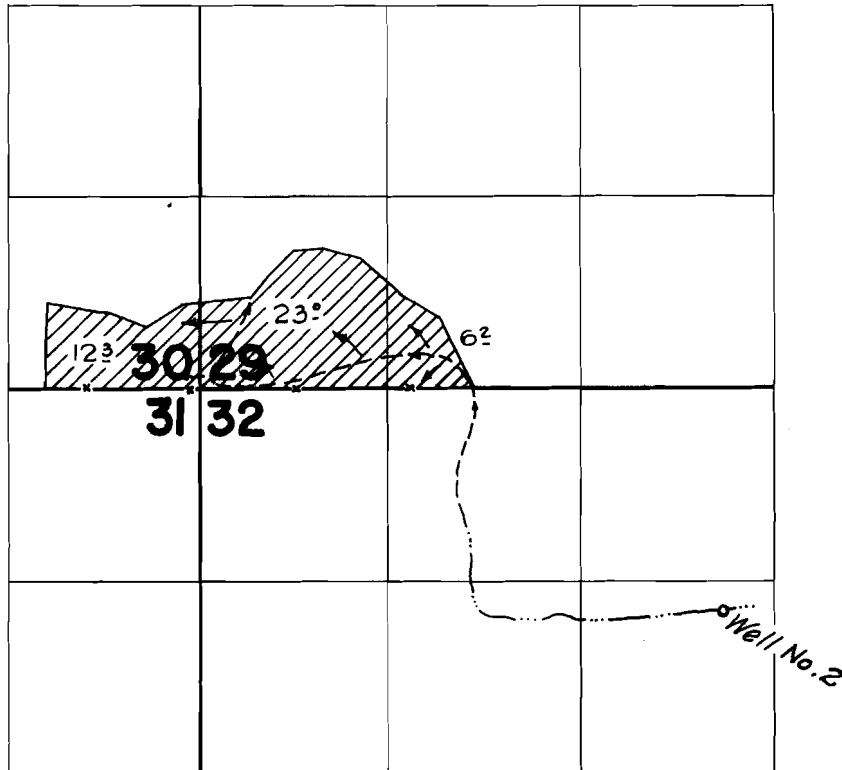

FINAL PROOF SURVEY
UNDER

Application No. G-2046 Permit No. G-1895
IN NAME OF

MILLER BROS.

Surveyed Sept. 11, 1963, by C. R. BAKER