


T.36S.R.2W.W.M.

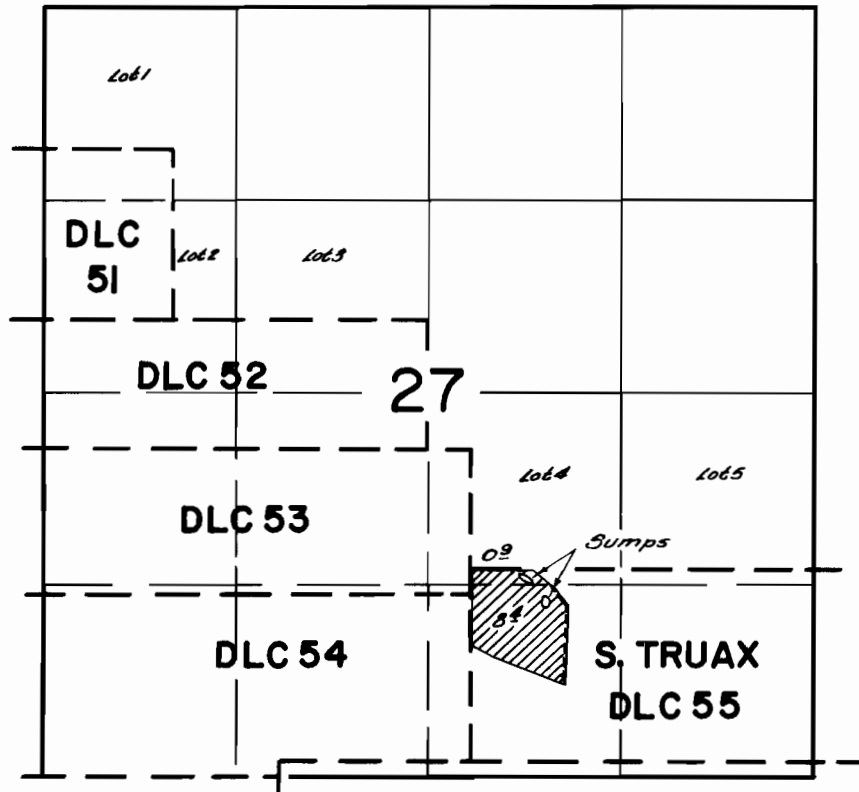

FINAL PROOF SURVEY
UNDER

Application No. G-1236 Permit No. G-1118
IN NAME OF

.....**Frank Wooldridge**.....

Surveyed July 11 1963, by G. Baker.....