


T.37S.R.2W.W.M.

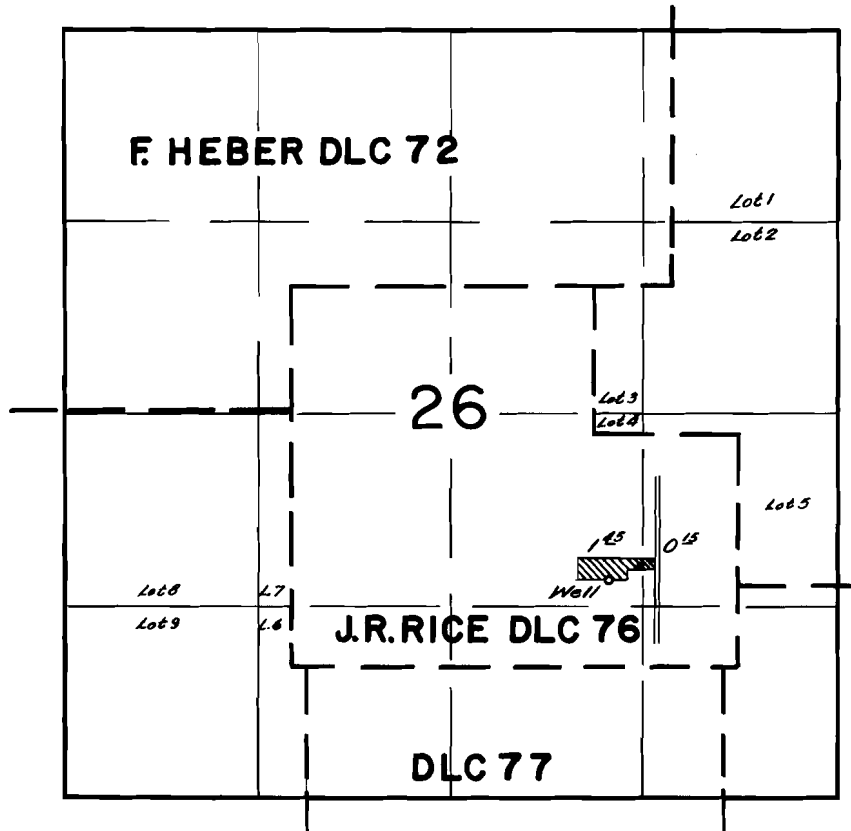

FINAL PROOF SURVEY
UNDER

Application No. G-1606 Permit No. G-1477
IN NAME OF

.....**Ernest F. Santo**.....

Surveyed May 15, 1963, by G. Baker.....