


T. 39S. R. 1W. W.M.

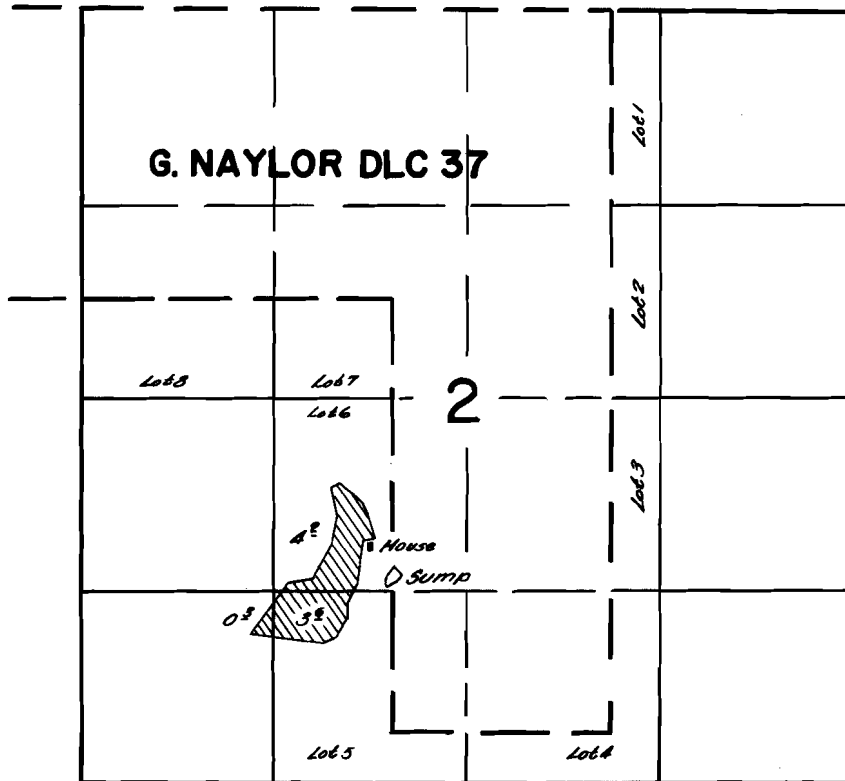

**FINAL PROOF SURVEY**  
UNDER

Application No. G-1655... Permit No. G-1533...  
IN NAME OF

**William Hust Jr.**

Surveyed May 16, 1963, by C. Baker