


T.38&39S.R.3W.W.M.

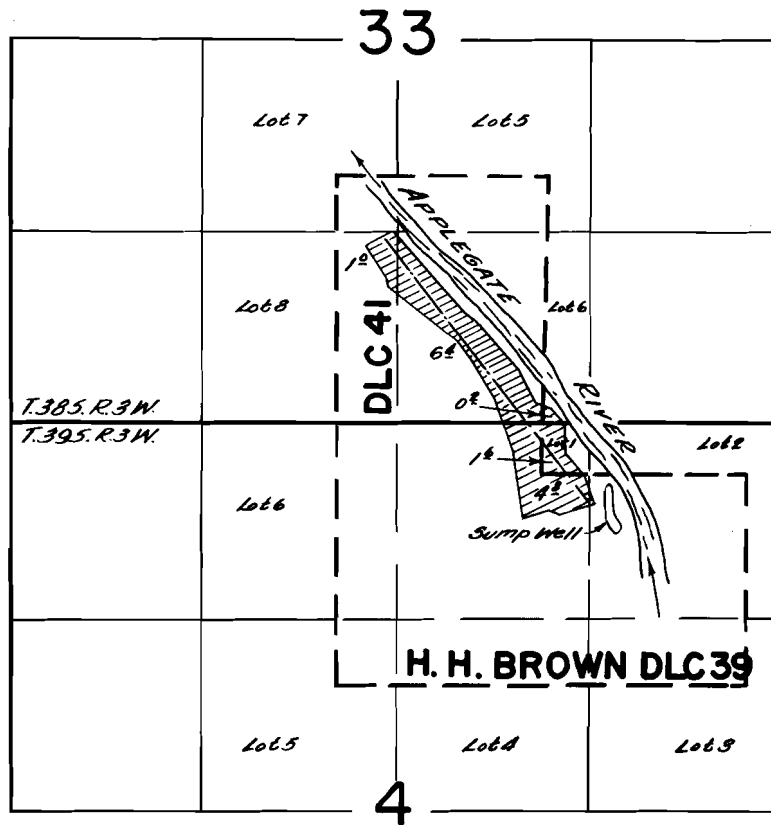

FINAL PROOF SURVEY
UNDER

Application No. G-1672 Permit No. G-1537
IN NAME OF

.....**Fred R. & Ethel M. West**.....

Surveyed May 15 1963, by C. Baker.....