


T. 38S. R. 3W. W.M.

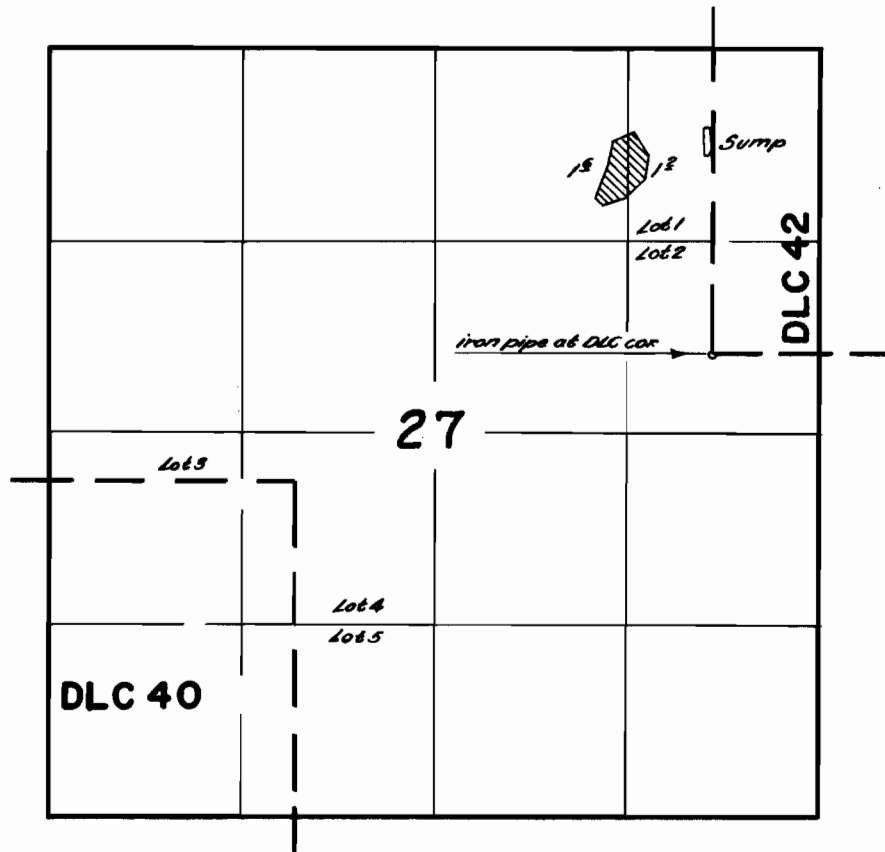

**FINAL PROOF SURVEY**  
UNDER

Application No. G-1800 Permit No. G-1646  
IN NAME OF

Ivan & Inez McDonough

Surveyed May 16 1963, by G. Baker