


T.33S.R.2E.W.M.

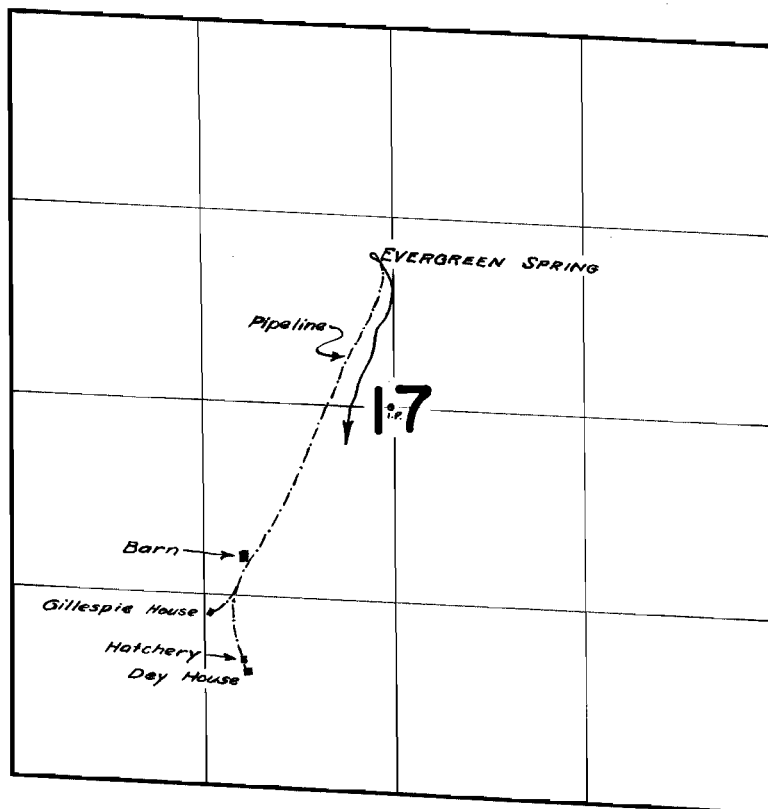

FINAL PROOF SURVEY
UNDER

Application No. 30933 Permit No. 24345
IN NAME OF

RUTH B. DEY & ELLA A. GILLESPIE

Surveyed May 17 1963, by *A. Jackson*