


T.39S.R.2E.W.M.

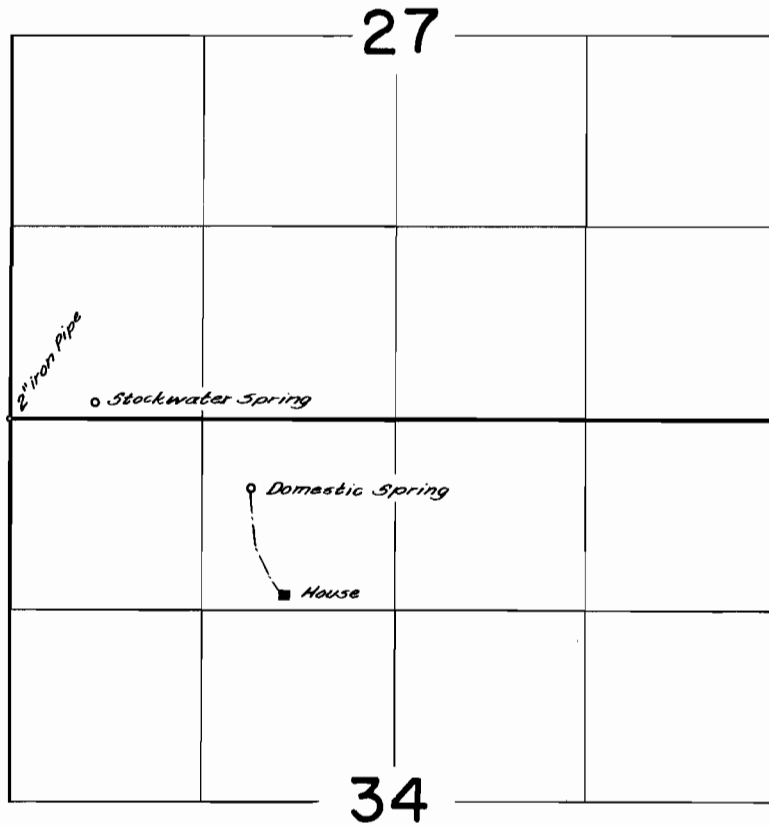

**FINAL PROOF SURVEY**  
UNDER

Application No. 31450 Permit No. 24800  
IN NAME OF

**Elmer Hopkins**

Surveyed May 14 1963, by C. Baker