


T.33S.R.2E.W.M.

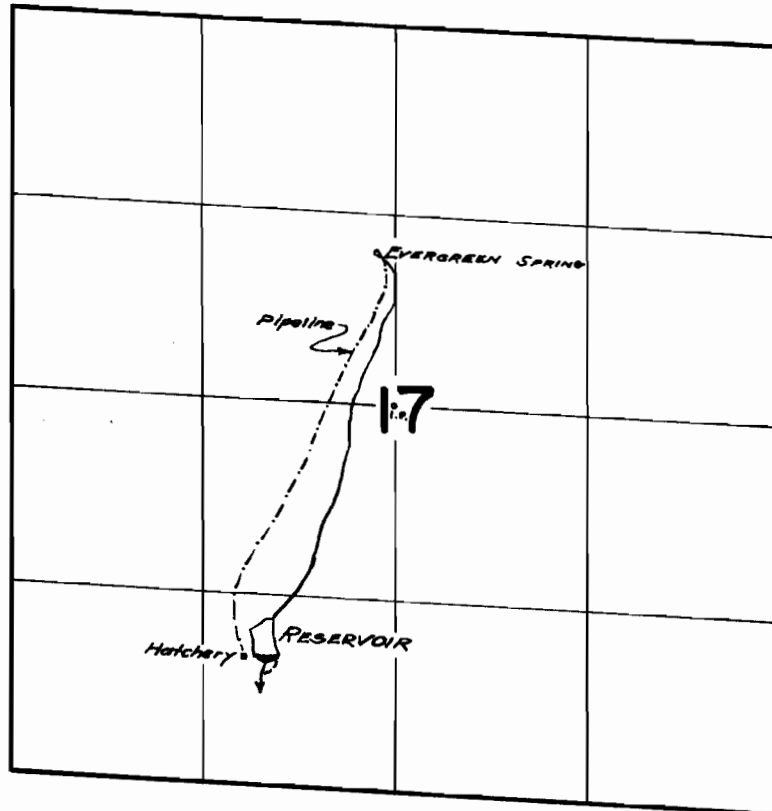

**FINAL PROOF SURVEY**  
UNDER

R-31991  
31992

R-2107  
25282

Application No. 34340... Permit No. 26988...  
IN NAME OF

MARCUS & RUTH B. DEY

Surveyed May 17, 1963, by *[Signature]*