


T.33S.R.2E.W.M.

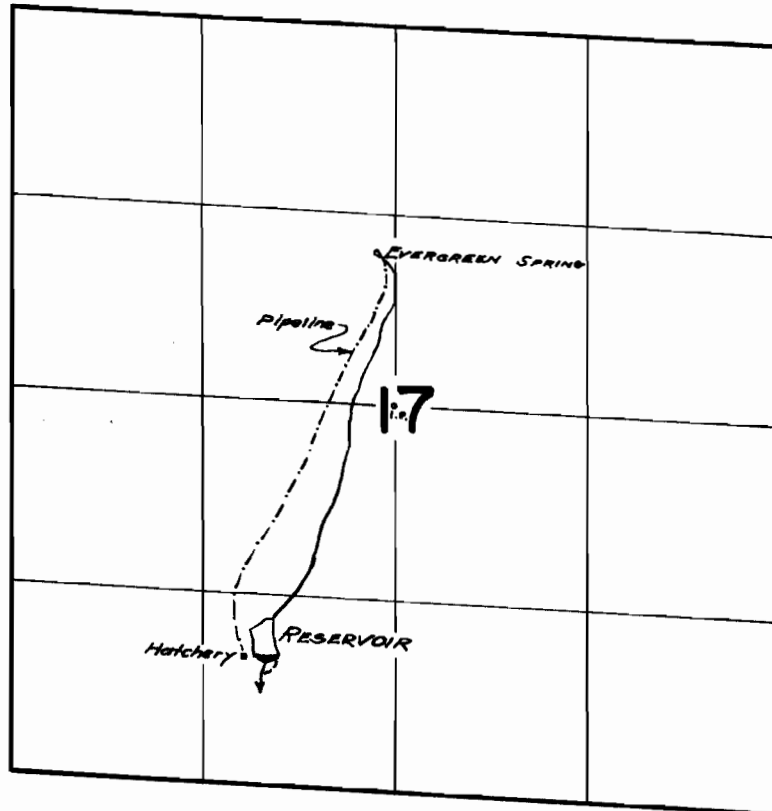

FINAL PROOF SURVEY
UNDER

R-31991
31992

R-2107
25282

Application No. 34340... Permit No. 26988...
IN NAME OF

MARCUS & RUTH B. DEY

Surveyed May 17, 1963, by

[Handwritten signature]