


T.38S.R.4W.W.M.

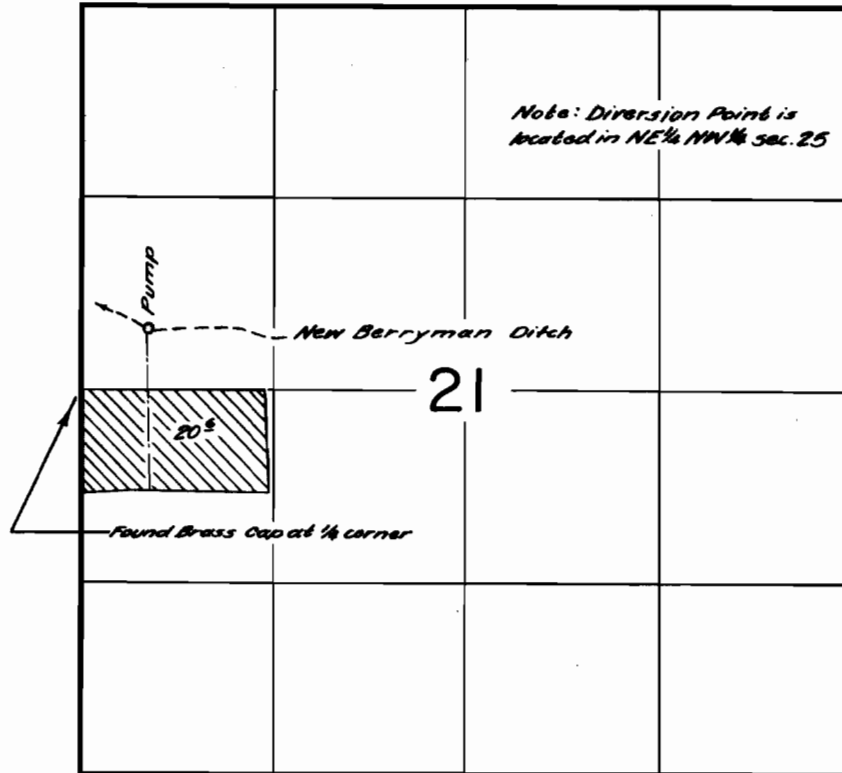

FINAL PROOF SURVEY
UNDER

Application No. 34650 Permit No. 27218.....
IN NAME OF

.....**W. C. Macy**.....

Surveyed June 6, 1963., by C. Baker.....