


T. 36 S. R. 4 W. W.M.

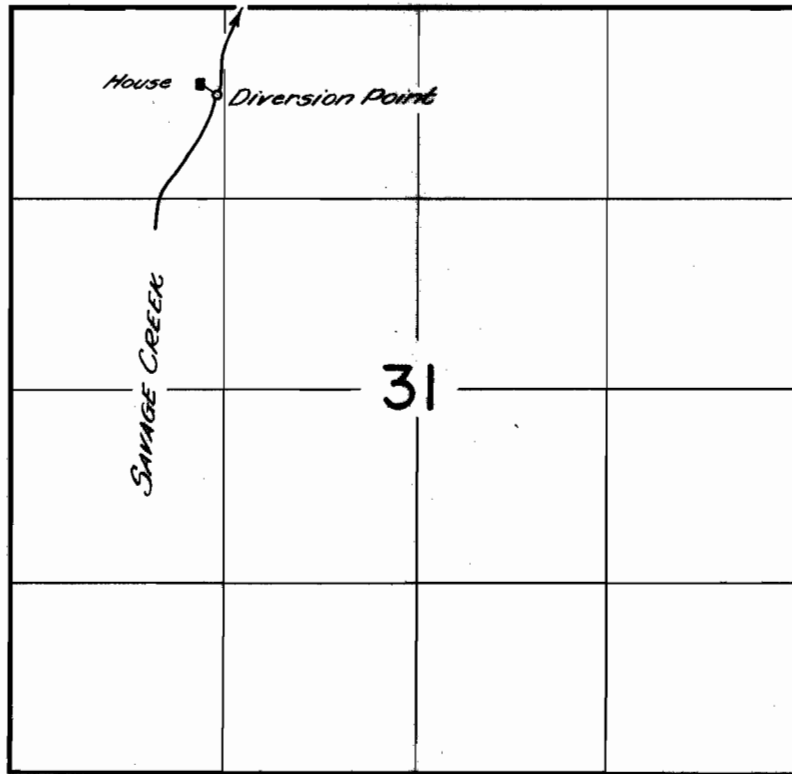

FINAL PROOF SURVEY
UNDER

Application No. 35093 Permit No. 27456...
IN NAME OF

.....**Lyall W. & Winnifred L. Hinch**.....

Surveyed July 13, 1963, by C. Baker.....