


# T.34 S.R. 1 W.W.M.

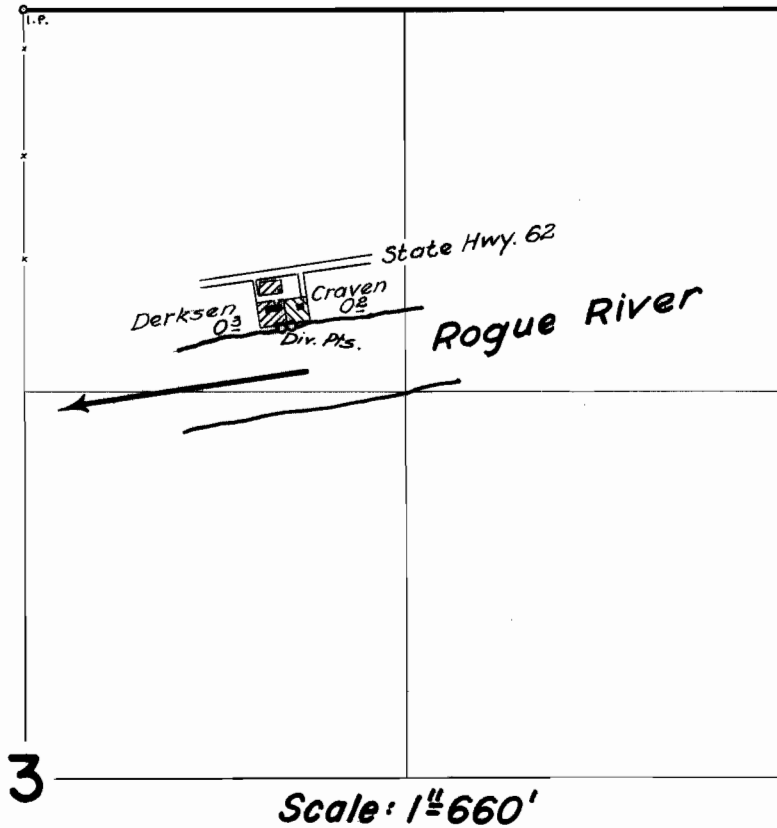

## FINAL PROOF SURVEY UNDER

Application No. 37172 Permit No. 27683  
IN NAME OF  
**R. A. & OLLIE M. DERKSEN**  
& **CAROL L. CRAVEN**

Surveyed May 21, 1963, by *A. Jackson*