


T. 38 S. R. 5 W.W.M.

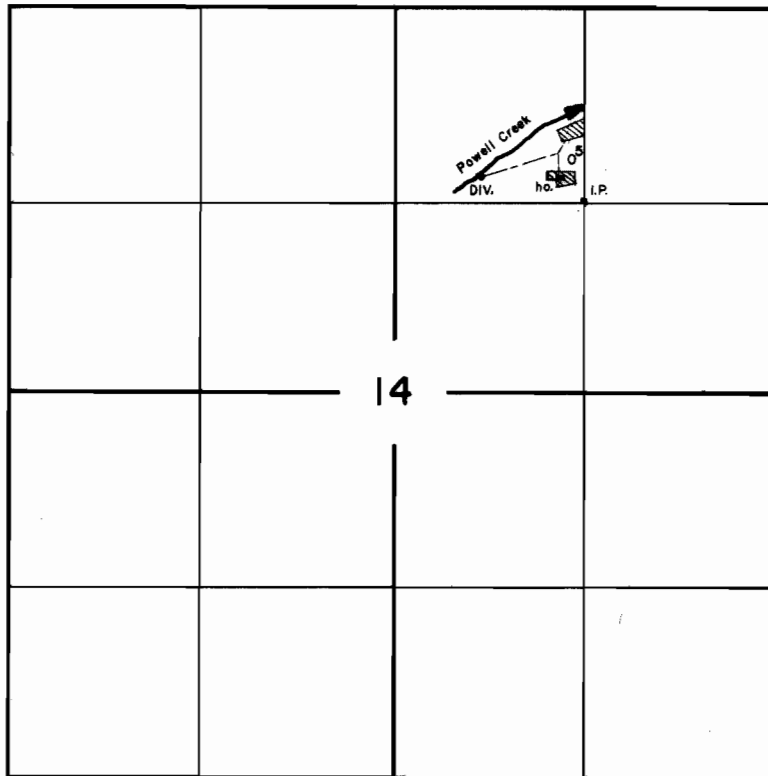

**FINAL PROOF SURVEY**  
UNDER

Application No. 37495 Permit No. 27911  
IN NAME OF

Loren J. &/or Mildred R. Ashmore

Surveyed May 22 1964, by R. B. Steimer