


T.33S.R.5W.W.M.

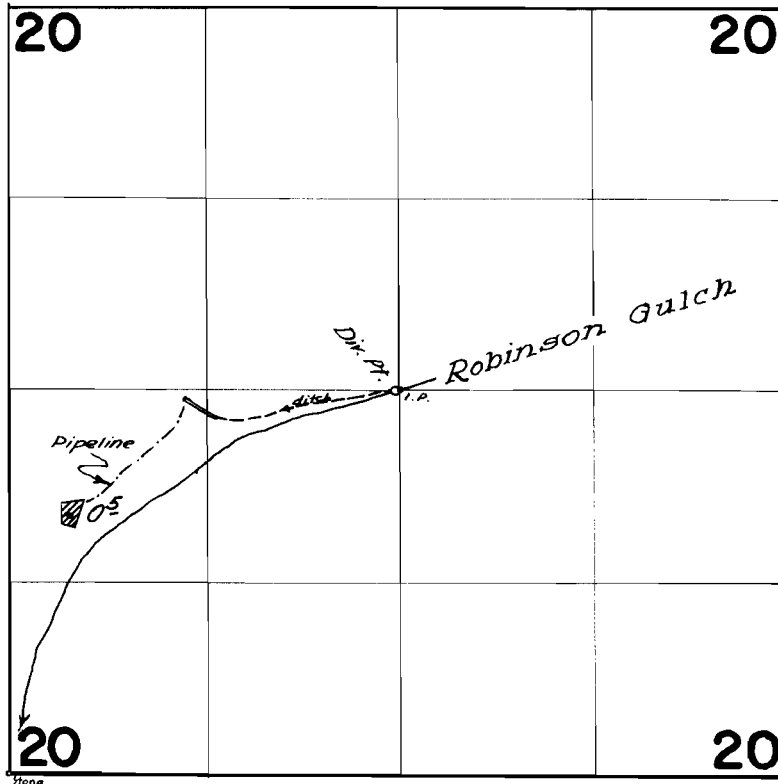

**FINAL PROOF SURVEY**  
UNDER

Application No. 38037 Permit No. 28346  
IN NAME OF

**HAROLD M<sup>C</sup>INTOSH**

Surveyed July 10 1963, by *R. Johnson*