


T.18S.R.3W.W.M.

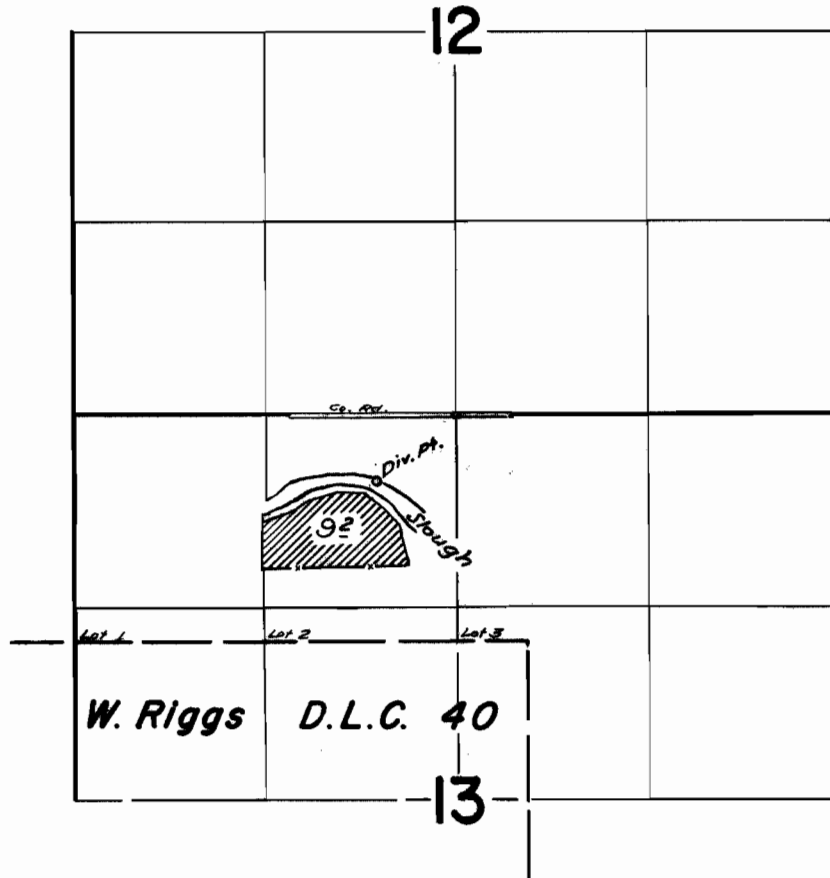

FINAL PROOF SURVEY UNDER

Application No. 33323 Permit No. 26545
IN NAME OF

CYRIL CRABTREE

Surveyed May 7, 1963, by [Signature]