


T.6 S.R.6 W.W.M.

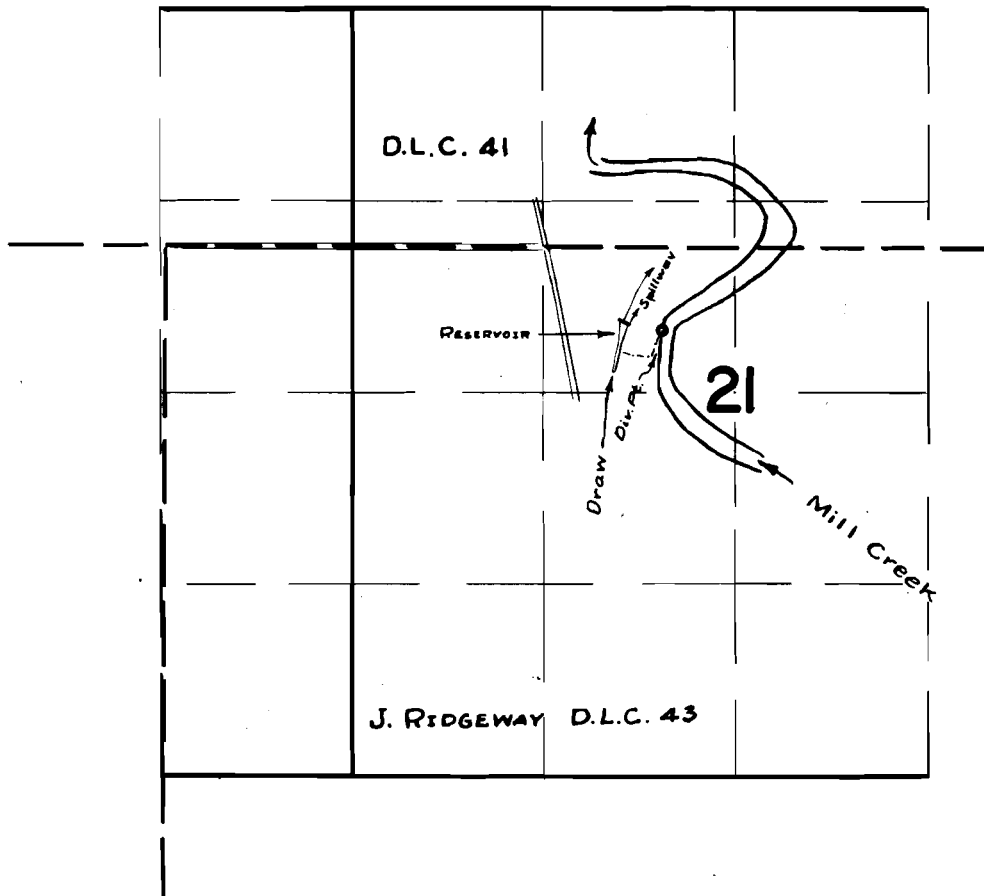

FINAL PROOF SURVEY UNDER

P-31884 *P-2075*
Application No. *31885* Permit No. *25131*
IN NAME OF

WM. P. HARRIS

Surveyed 28 JULY 1961, by *m. Bish*