


T.7&8 S.R.3W.W.M.

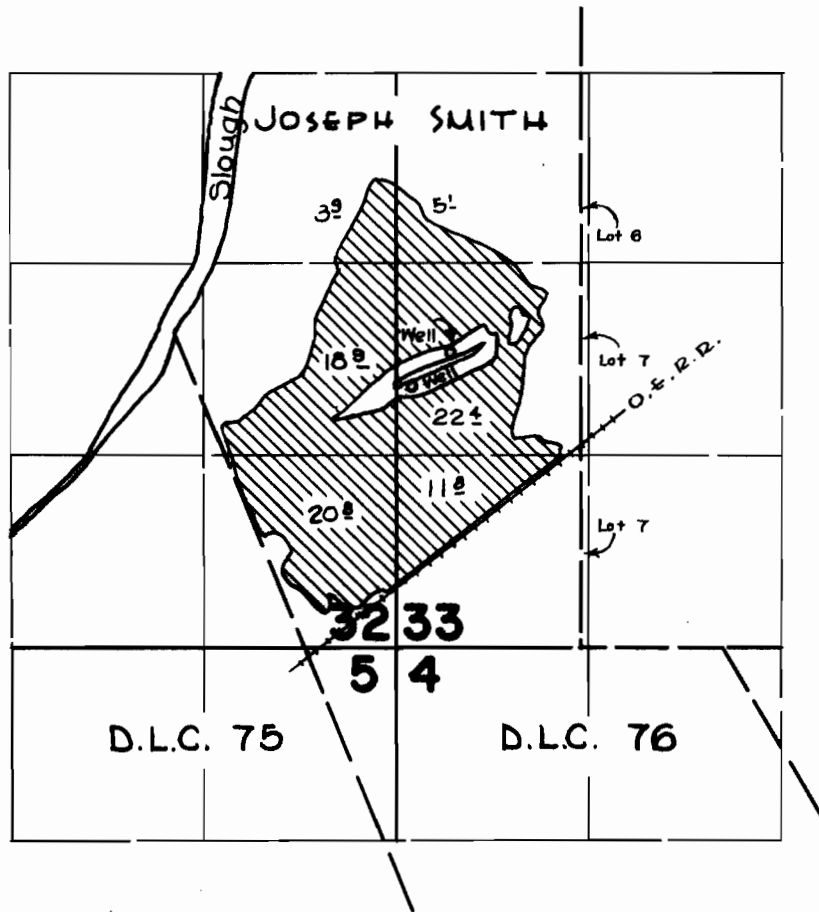

FINAL PROOF SURVEY UNDER

Application No. G-1219 G-964
G-1513 Permit No. G-1381
IN NAME OF

SALEM GOLF CLUB

Surveyed July 22, 1963, by F.L. SIEGMUND.