


T.7&8 S. R. 3 W. W. M.

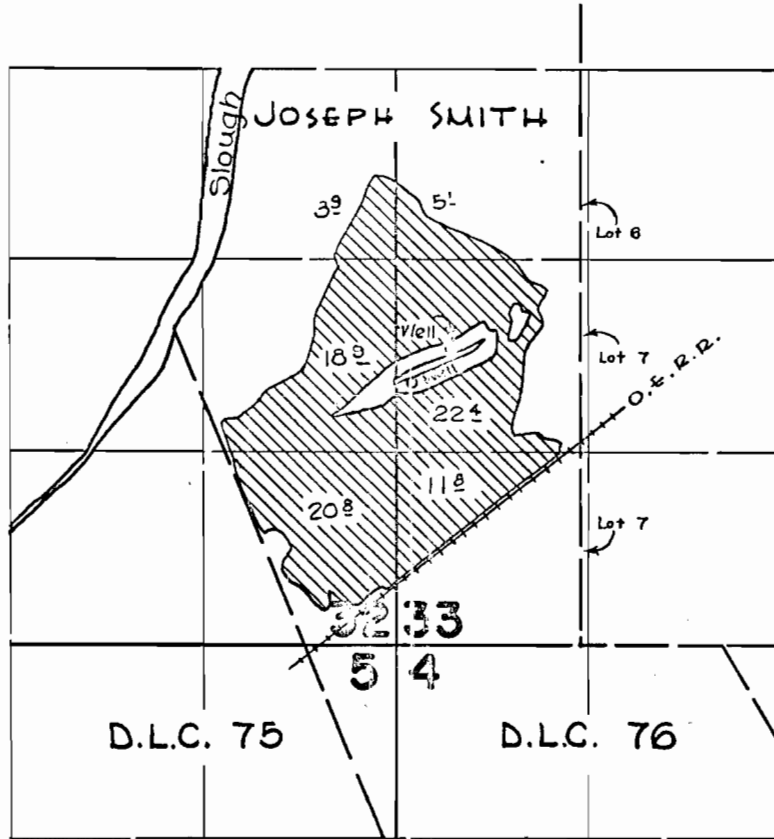

FINAL PROOF SURVEY  
UNDER

Application No. G-1219 G-964  
G-1513 Permit No. G-1381  
IN NAME OF

SALEM GOLF CLUB

Surveyed July 22, 1963, by F. L. SIEGMUND.