


T.5S.R.1W.W.M.

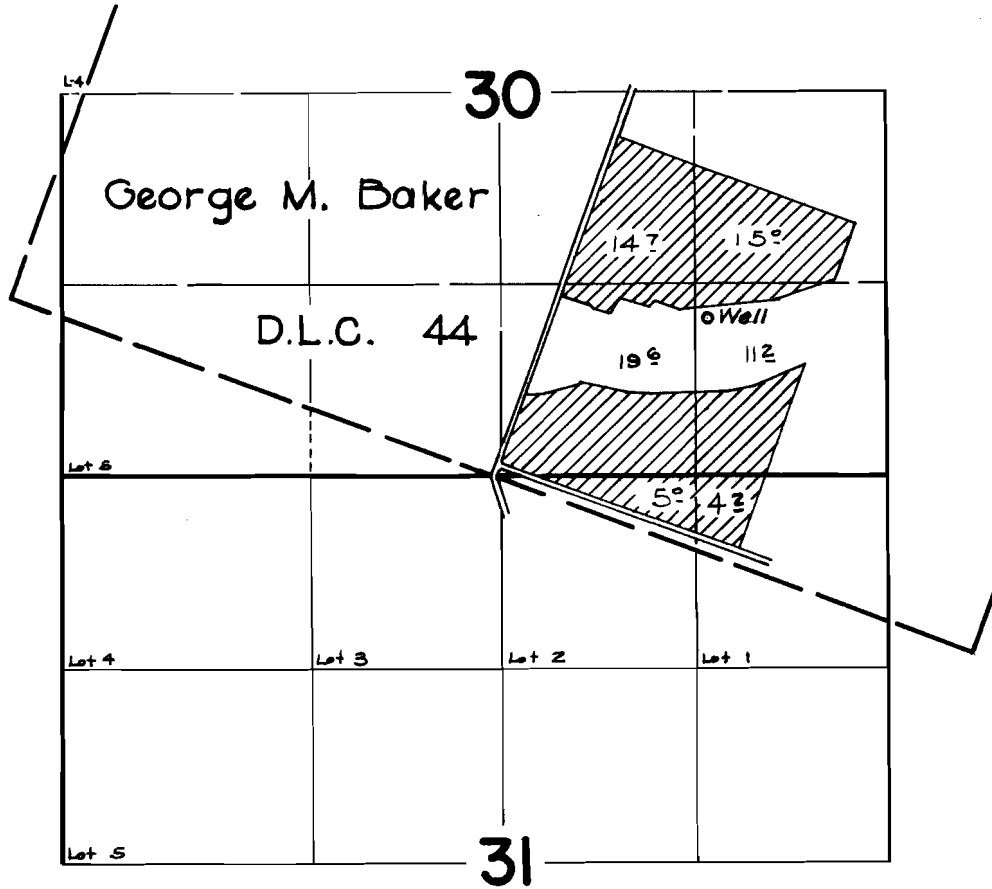

**FINAL PROOF SURVEY**  
UNDER

Application No. G-1587. Permit No. G-1458  
IN NAME OF

ESTATE OF GEORGE EDER

Surveyed April 22 1963, by T. LAUER.

*LA*