


T.6S.R.3W.W.M.

Section 34

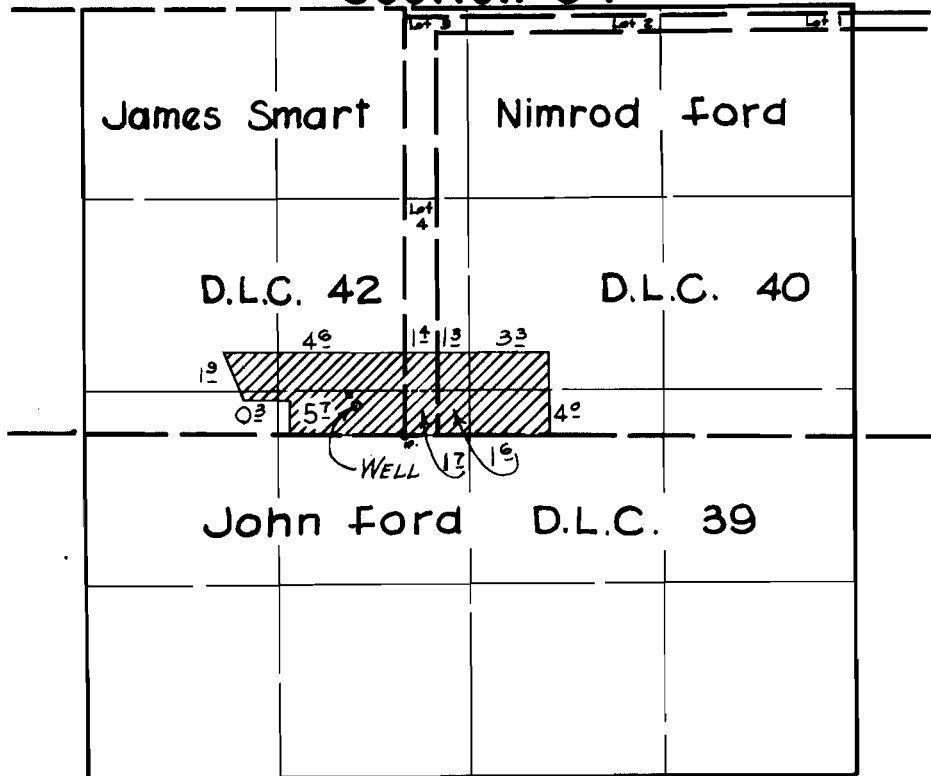

FINAL PROOF SURVEY UNDER

Application No. G-2135 Permit No. G-1972
IN NAME OF

ROY J. HOFFMAN

Surveyed April 24 1963, by T. LAUER